

1 LOCATION OF WATER WELL:		Fraction NW 1/4 NW 1/4 NW 1/4	Section Number 22	Township Number T 27 S	Range Number R 4 E
---------------------------	--	----------------------------------	----------------------	---------------------------	-----------------------

Distance and direction from nearest town or city street address of well if located within city?

Approximately 300' west of 1315 Money St. in Augusta.

2 WATER WELL OWNER: KANE Pipeline Company


RR#, St. Address, Box #: 100 North Broadway, Suite 550

Board of Agriculture, Division of Water Resources

City, State, ZIP Code: Wichita, Ks. 67202

Application Number:

3 LOCATE WELL'S LOCATION WITH AN "X" IN SECTION BOX:

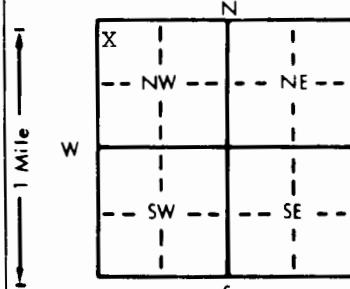

4 DEPTH OF COMPLETED WELL. 16 ft. ELEVATION:

Depth(s) Groundwater Encountered 1 ft. 2 ft. 3 ft.

WELL'S STATIC WATER LEVEL 11 1/2 ft. below land surface measured on mo/day/yr 7/31/90

Pump test data: Well water was ft. after hours pumping gpm

Est. Yield gpm: Well water was ft. after hours pumping gpm

Bore Hole Diameter in. to ft. and in. to ft.

WELL WATER TO BE USED AS: 5 Public water supply 8 Air conditioning 11 Injection well

1 Domestic 3 Feedlot 6 Oil field water supply 9 Dewatering 12 Other (Specify below)

2 Irrigation 4 Industrial 7 Lawn and garden only 10 Monitoring well

Was a chemical/bacteriological sample submitted to Department? Yes No X; If yes, mo/day/yr sample was submitted

Water Well Disinfected? Yes No X

5 TYPE OF BLANK CASING USED: 5 Wrought iron 8 Concrete tile CASING JOINTS: Glued Clamped

1 Steel 3 RMP (SR) 6 Asbestos-Cement 9 Other (specify below) Welded

2 PVC 4 ABS 7 Fiberglass Threaded X

Blank casing diameter in. to 16 ft. Dia in. to ft. Dia in. to ft.

Casing height above land surface 30 in., weight 2,411 lbs./ft. Wall thickness or gauge No. 248" W

TYPE OF SCREEN OR PERFORATION MATERIAL: 7 PVC 10 Asbestos-cement

1 Steel 3 Stainless steel 5 Fiberglass 8 RMP (SR) 11 Other (specify)

2 Brass 4 Galvanized steel 6 Concrete tile 9 ABS 12 None used (open hole)

SCREEN OR PERFORATION OPENINGS ARE: 5 Gauzed wrapped 8 Saw cut 11 None (open hole)

1 Continuous slot 3 Mill slot 6 Wire wrapped 9 Drilled holes

2 Louvered shutter 4 Key punched 7 Torch cut 10 Other (specify)

SCREEN-PERFORATED INTERVALS: From 7 1/2 ft. to 16 ft. From ft. to ft. From ft. to ft.

From ft. to ft. From ft. to ft. From ft. to ft.

GRAVEL PACK INTERVALS: From 6 ft. to 16 ft. From ft. to ft. From ft. to ft.

From ft. to ft. From ft. to ft. From ft. to ft.

6 GROUT MATERIAL: 1 Neat cement 2 Cement grout 3 Bentonite 4 Other

Grout Intervals: From 0 ft. to 3 ft. From 3 ft. to 6 ft. From ft. to ft.

What is the nearest source of possible contamination:

1 Septic tank 4 Lateral lines 7 Pit privy 10 Livestock pens 14 Abandoned water well

2 Sewer lines 5 Cess pool 8 Sewage lagoon 11 Fuel storage 15 Oil well/Gas well

3 Watertight sewer lines 6 Seepage pit 9 Feedyard 12 Fertilizer storage 16 Other (specify below)

13 Insecticide storage Petroleum Product

14 Pipeline

Direction from well? West How many feet? 50'

FROM TO LITHOLOGIC LOG FROM TO PLUGGING INTERVALS

0 3 Top soil

3 5 Dark brown clay

5 7 Light brown sandy clay

7 10 Dark brown clay

10 15 Fine to medium sand & clay mixed

15 16 Dark brown clay


16 Limestone

7 CONTRACTOR'S OR LANDOWNER'S CERTIFICATION: This water well was (1) constructed, (2) reconstructed, or (3) plugged under my jurisdiction and was completed on (mo/day/year) 7/31/90 and this record is true to the best of my knowledge and belief. Kansas

Water Well Contractor's License No. 145 This Water Well Record was completed on (mo/day/yr) August 31, 1990

under the business name of Henkle Drilling & Supply Co., Inc. by (signature) *Benny J. Henkle*

INSTRUCTIONS: Use typewriter or ball point pen. PLEASE PRESS FIRMLY and PRINT clearly. Please fill in blanks, underline or circle the correct answers. Send top three copies to Kansas Department of Health and Environment, Bureau of Water, Topeka, Kansas 66620-7320. Telephone: 913-296-5545. Send one to WATER WELL OWNER and retain one for your records.

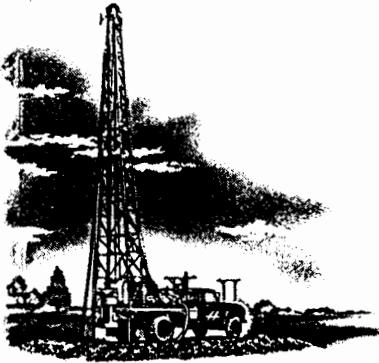

Henkle

3795 W. JONES AVE.
316/277-2389
FAX/277-0224

DRILLING & SUPPLY CO., INC.

P.O. Box 639
GARDEN CITY, KANSAS 67846

%	FOOTAGE			DESCRIPTION OF STRATA	STATIC WATER LEVEL: 11' 5 3/4"
	From	Pay	To		Proposed Well Depth:
	0		3	Top soil	
	3		5	Dark brown clay	
	5		7	Light brown sandy clay	
	7		10	Dark brown clay	
	10		15	Sand fine to medium & clay mixed	
	15		16	Dark brown clay	
	16		16	Weathered limestone	
				4" cap	
				8 $\frac{1}{2}$ ' perf	
				7 $\frac{1}{2}$ ' plain	
				7 $\frac{1}{2}$ - buckets of Colorado Silica sand	
				2 - bags of Hole Plug	
				4" J plug	
				4" PVC flush joint	
				Perf	Plain
				8 $\frac{1}{2}$ '	
					7 $\frac{1}{2}$ '
					30" riser
				Gravel from 16' to 6'	
				Hole plug 6' to 3'	
				1 - above ground casing protector	
				4 - sacks of Quick-Rete	