

1 LOCATION OF WATER WELL:	Fraction	Section Number	Township Number	Range Number
County: BUTLER	SW 1/4 SW 1/4 SW 1/4	22	T 27 S	R 4 E

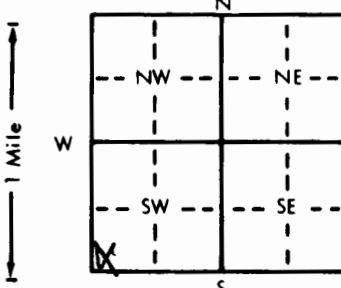
Distance and direction from nearest town or city street address of well if located within city?

610 W 7th AUGUSTA KS2 WATER WELL OWNER: **COASTAL**

RR#, St. Address, Box #

610 W 7th AUGUSTA KS

3 LOCATE WELL'S LOCATION WITH AN "X" IN SECTION BOX:

4 DEPTH OF COMPLETED WELL **20** ft. ELEVATION:Depth(s) Groundwater Encountered **1** ft. 2. ft. 3. ft.WELL'S STATIC WATER LEVEL **15** ft. below land surface measured on mo/day/yr

Pump test data: Well water was ft. after hours pumping gpm

Est. Yield **30** gpm: Well water was ft. after hours pumping gpmBore Hole Diameter **30** in. to ft. and in. to ft.

WELL WATER TO BE USED AS: 5 Public water supply 8 Air conditioning 11 Injection well

1 Domestic 3 Feedlot 6 Oil field water supply 9 Dewatering 12 Other (Specify below)

2 Irrigation 4 Industrial 7 Lawn and garden only 10 Monitoring well

Was a chemical/bacteriological sample submitted to Department? Yes No If yes, mo/day/yr sample was submittedWater Well Disinfected? Yes No

5 TYPE OF BLANK CASING USED:

1 Steel 3 RMP (SR)
 2 PVC 4 ABS

Blank casing diameter **2** in. to **10** ft., Dia. in. to ft., Dia. in. to ft.

Casing height above land surface in., weight lbs./ft. Wall thickness or gauge No.

TYPE OF SCREEN OR PERFORATION MATERIAL:

1 Steel 3 Stainless steel
 2 Brass 4 Galvanized steel

5 Wrought iron 8 Concrete tile CASING JOINTS: Glued Clamped

6 Asbestos-Cement 9 Other (specify below) Welded

7 Fiberglass Threaded

SCREEN OR PERFORATION OPENINGS ARE:

1 Continuous slot 3 Mill slot
 2 Louvered shutter 4 Key punched

7 PVC 10 Asbestos-cement

11 Other (specify)

12 None used (open hole)

SCREEN-PERFORATED INTERVALS: From **10** ft. to **20** ft., From ft. to ft.

5 Gauzed wrapped 8 Saw cut 11 None (open hole)

6 Wire wrapped 9 Drilled holes

7 Torch cut 10 Other (specify)

10 Other (specify)

11 Other (specify)

12 None used (open hole)

13 Insecticide storage

14 Abandoned water well

15 Oil well/Gas well

16 Other (specify below)

How many feet? **WITHIN STATION**GRAVEL PACK INTERVALS: From **9** ft. to **20** ft., From ft. to ft.

6 GROUT MATERIAL: 1 Neat cement 2 Cement grout 3 Bentonite 4 Other

Grout Intervals: From **9** ft. to **9** ft., From ft. to ft., From ft. to ft.

10 Livestock pens

11 Fuel storage

12 Fertilizer storage

13 Insecticide storage

14 Abandoned water well

15 Oil well/Gas well

16 Other (specify below)

Direction from well? **WITHIN STATION**7 CONTRACTOR'S OR LANDOWNER'S CERTIFICATION: This water well was (1) constructed, (2) reconstructed, or (3) plugged under my jurisdiction and was completed on (mo/day/year) **7/1/92** and this record is true to the best of my knowledge and belief. KansasWater Well Contractor's License No. **102** This Water Well Record was completed on (mo/day/yr) **7/9/92** by (signature) **John Western**under the business name of **JOHN WESTERN**