

1 LOCATION OF WATER WELL:

Fraction

County: Butler

SW  $\frac{1}{4}$  SE  $\frac{1}{4}$  SW  $\frac{1}{4}$ 

Section Number

Township Number

Range Number

Distance and direction from nearest town or city street address of well if located within city?

520 W. 7th Street, Augusta KS

2 WATER WELL OWNER:

Roger Carpenter

812 W 11th

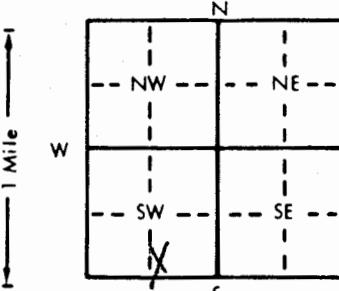
Board of Agriculture, Division of Water Resources

RR#, St. Address, Box #:

Coffeyville KS 67337

Application Number:

City, State, ZIP Code:

3 LOCATE WELL'S LOCATION WITH  
AN "X" IN SECTION BOX:

4 DEPTH OF COMPLETED WELL... 24.5

ft. ELEVATION: NA

Depth(s) Groundwater Encountered 12.70

ft. 2

ft. 3

WELL'S STATIC WATER LEVEL NA ft. below land surface measured on mo/day/yr NA

Pump test data: Well water was ft. after hours pumping gpm

Est. Yield gpm: Well water was ft. after hours pumping gpm

Bore Hole Diameter 8 in. to ft. and in. to ft.

WELL WATER TO BE USED AS: 5 Public water supply 8 Air conditioning 11 Injection well

1 Domestic 3 Feedlot 6 Oil field water supply 9 Dewatering 12 Other (Specify below)

2 Irrigation 4 Industrial 7 Lawn and garden only 10 Monitoring well Temporary

Was a chemical/bacteriological sample submitted to Department? Yes No X; If yes, mo/day/yr sample was submitted Water Well Disinfected? Yes No X

5 TYPE OF BLANK CASING USED:

1 Steel 3 RMP (SR)  
2 PVC 4 ABS

5 Wrought iron 8 Concrete tile CASING JOINTS: Glued Clamped

6 Asbestos-Cement 9 Other (specify below) Welded

7 Fiberglass Threaded. Flush

Blank casing diameter in. to ft. Dia in. to ft. Dia in. to ft.

Casing height above land surface 6.0 in. weight 70.3 lbs./ft. Wall thickness or gauge No. 154

TYPE OF SCREEN OR PERFORATION MATERIAL:

1 Steel 3 Stainless steel 5 Fiberglass 8 RMP (SR)  
2 Brass 4 Galvanized steel 6 Concrete tile 9 ABS  
1 Continuous slot 3 Mill slot  
2 Louvered shutter 4 Key punched

6 PVC 10 Asbestos-cement

11 Other (specify) 12 None used (open hole)

5 Gauzed wrapped 8 Saw cut 11 None (open hole)  
6 Wire wrapped 9 Drilled holes  
7 Torch cut 10 Other (specify)

SCREEN-PERFORATED INTERVALS: From 9.5 ft. to 24.5 ft. From ft. to ft. From ft. to ft.

From ft. to ft. From ft. to ft. From ft. to ft.

GRAVEL PACK INTERVALS: From 8.5 ft. to 24.5 ft. From ft. to ft. From ft. to ft.

From ft. to ft. From ft. to ft. From ft. to ft.

6 GROUT MATERIAL: 1 Neat cement 2 Cement grout 3 Bentonite 4 Other

Grout Intervals: From 8.5 ft. to 0.0 ft. From ft. to ft. From ft. to ft. From ft. to ft.

What is the nearest source of possible contamination:

1 Septic tank 4 Lateral lines 7 Pit privy 10 Livestock pens 14 Abandoned water well  
2 Sewer lines 5 Cess pool 8 Sewage lagoon 11 Fuel storage 15 Oil well/Gas well  
3 Watertight sewer lines 6 Seepage pit 9 Feedyard 12 Fertilizer storage 16 Other (specify below)

Direction from well? NA

13 Insecticide storage  
How many feet? NA

FROM TO LITHOLOGIC LOG FROM TO PLUGGING INTERVALS

7.0 8.5 Clay, plastic, moist 1.0 3.0 Cutting  
8.5 18.5 Clay, very plastic, dark grey moist 3.0 24.5 Bentonite chips

8.5 22.0 Clay, slightly silty, very plastic, greyish brown, wet

22.0 24.0 Clay, sandy, slightly silty, wet, greyish brown

4.0 24.5 Limestone, slightly weathered, tan

RECEIVED

OCT 08 1992

DIVISION OF  
ENVIRONMENT

7 CONTRACTOR'S OR LANDOWNER'S CERTIFICATION: This water well was (1) constructed (2) reconstructed, or (3) plugged under my jurisdiction and was completed on (mo/day/year) 9-11-92/9-15-92 and this record is true to the best of my knowledge and belief. Kansas

Water Well Contractor's License No. 531 This Water Well Record was completed on (mo/day/year) 9-30-92

under the business name of Geotechnical Services, Inc. by (signature) Allison J. twin

INSTRUCTIONS: Use typewriter or ball point pen. PLEASE PRESS FIRMLY and PRINT clearly. Please fill in blanks, underline or circle the correct answers. Send top three copies to Kansas Department of Health and Environment, Bureau of Water, Topeka, Kansas 66620-0001. Telephone: 913-296-5545. Send one to WATER WELL OWNER and retain one for your records.