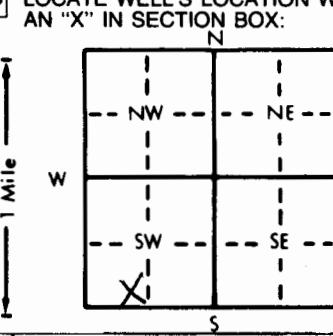


MW-7 211049 WATER WELL RECORD Form WWC-5 KSA 82a-1212

1 LOCATION OF WATER WELL: County: <u>Butler</u>	Fraction: <u>SE 1/4 SW 1/4 SW 1/4</u>	Section Number: <u>22</u>	Township Number: <u>T 27 S</u>	Range Number: <u>R 4 E/W</u>	
Distance and direction from nearest town or city street address of well if located within city? <u>7th &amp; Lulu in 300 ft N8 NW corner</u>					
2 WATER WELL OWNER: RR#, St. Address, Box #: City, State, ZIP Code :	Coastal Remediation Corp PO Box 1030 Wichita KS 67201-1030				Board of Agriculture, Division of Water Resources Application Number:
3 LOCATE WELL'S LOCATION WITH AN "X" IN SECTION BOX: 	4 DEPTH OF COMPLETED WELL: <u>20</u> ft. ELEVATION: <u>15</u> ft. Depth(s) Groundwater Encountered: <u>1</u> ft. 2. ft. 3. ft. WELL'S STATIC WATER LEVEL: <u>13.60</u> ft. below land surface measured on mo/day/yr <u>1-5-94</u> Pump test data: Well water was ft. after hours pumping gpm Est. Yield gpm. Well water was ft. after hours pumping gpm Bore Hole Diameter: <u>8</u> in. to ft. and in. to ft. WELL WATER TO BE USED AS: 5 Public water supply 8 Air conditioning 11 Injection well 1 Domestic 3 Feedlot 6 Oil field water supply 9 Dewatering 12 Other (Specify below) 2 Irrigation 4 Industrial 7 Lawn and garden only 10 Monitoring well Was a chemical/bacteriological sample submitted to Department? Yes <input checked="" type="checkbox"/> No <input type="checkbox"/> If yes, mo/day/yr sample was submitted Water Well Disinfected? Yes <input type="checkbox"/> No <input checked="" type="checkbox"/>				
5 TYPE OF BLANK CASING USED: 1 Steel 3 RMP (SR) <u>2 PVC</u> 4 ABS	5 Wrought iron 6 Asbestos-Cement 7 Fiberglass	8 Concrete tile 9 Other (specify below)	CASING JOINTS: Glued <input type="checkbox"/> Clamped <input type="checkbox"/> Welded <input type="checkbox"/> Threaded <u>Flush</u>		
Blank casing diameter in. to ft. Dia in. to ft. Dia in. to ft.	Casing height above land surface <u>Flush</u> in. weight <u>703</u> lbs./ft. Wall thickness or gauge No. <u>.154</u>				
TYPE OF SCREEN OR PERFORATION MATERIAL: 1 Steel 3 Stainless steel 5 Fiberglass 8 RMP (SR) 10 Asbestos-cement 2 Brass 4 Galvanized steel 6 Concrete tile 9 ABS 11 Other (specify) 12 None used (open hole)					
SCREEN OR PERFORATION OPENINGS ARE: 1 Continuous slot <u>3 Mill slot</u> 5 Gauzed wrapped 8 Saw cut 11 None (open hole) 2 Louvered shutter 4 Key punched 6 Wire wrapped 9 Drilled holes 7 Torch cut 10 Other (specify)					
SCREEN-PERFORATED INTERVALS: From. <u>10</u> ft. to <u>20</u> ft. From. ft. to ft. From. ft. to ft.					
GRAVEL PACK INTERVALS: From. <u>9</u> ft. to <u>20</u> ft. From. ft. to ft. From. ft. to ft.					
6 GROUT MATERIAL: 1 Neat cement Grout Intervals: From. <u>9</u> ft. to <u>2</u> ft., From. ft. to ft., From. ft. to ft., From. ft. to ft.	2 Cement grout 3 Bentonite	4 Other	10 Livestock pens 11 Fuel storage 12 Fertilizer storage 13 Insecticide storage How many feet? <u>220</u>		
What is the nearest source of possible contamination: 1 Septic tank 4 Lateral lines 7 Pit privy 10 Livestock pens 14 Abandoned water well 2 Sewer lines 5 Cess pool 8 Sewage lagoon 11 Fuel storage 15 Oil well/Gas well 3 Watertight sewer lines 6 Seepage pit 9 Feedyard 12 Fertilizer storage 16 Other (specify below)					
Direction from well? <u>South</u>					
FROM <u>0.0</u> TO <u>2.0</u>	LITHOLOGIC LOG <u>Clay, red</u>		FROM	TO	PLUGGING INTERVALS
2.0 7.0	<u>Clay, dark brown</u>				
7.0 12.0	<u>Clay, brown</u>				
12.0 20.0	<u>Sand, clayey</u>				
7 CONTRACTOR'S OR LANDOWNER'S CERTIFICATION: This water well was (1) constructed, (2) reconstructed, or (3) plugged under my jurisdiction and was completed on (mo/day/year) <u>1-5-94</u> , and this record is true to the best of my knowledge and belief. Kansas					
Water Well Contractor's License No. <u>531</u> , This Water Well Record was completed on (mo/day/yr) <u>1-7-94</u> , by (signature) <u>Allison Truett</u>					
INSTRUCTIONS: Use typewriter or ball point pen. PLEASE PRESS FIRMLY and PRINT clearly. Please fill in blanks, underline or circle the correct answers. Send top three copies to Kansas Department of Health and Environment, Bureau of Water, Topeka, Kansas 66620-0001. Telephone: 913-296-5545. Send one to WATER WELL OWNER and retain one for your records.					