

MW-10

2111049

WATER WELL RECORD

Form WWC-5

KSA 82a-1212

1 LOCATION OF WATER WELL:

Fraction

Section Number

Township Number

Range Number

County: Butler

SE $\frac{1}{4}$ SW $\frac{1}{4}$ SW $\frac{1}{4}$

22

T 27 S

R 4 E/W

Distance and direction from nearest town or city street address of well if located within city?

620 W 7th Street

2 WATER WELL OWNER:

Coastal Remediation Corp.

RR#, St. Address, Box # :

PO Box 1030


Board of Agriculture, Division of Water Resources

City, State, ZIP Code :

Wichita KS 67201-1030

Application Number:

3 LOCATE WELL'S LOCATION WITH AN "X" IN SECTION BOX:

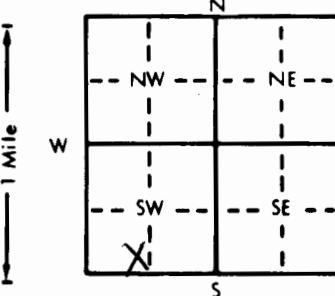

4 DEPTH OF COMPLETED WELL: 22 ft. ELEVATION:

Depth(s) Groundwater Encountered 1. 18 ft. 2. ft. 3. ft.

WELL'S STATIC WATER LEVEL 14.88 ft. below land surface measured on mo/day/yr

Pump test data: Well water was ft. after hours pumping gpm

Est. Yield gpm: Well water was ft. after hours pumping gpm

Bore Hole Diameter 8 in. to ft. and in. to ft.

WELL WATER TO BE USED AS: 5 Public water supply 8 Air conditioning 11 Injection well

1 Domestic 3 Feedlot 6 Oil field water supply 9 Dewatering 12 Other (Specify below)

2 Irrigation 4 Industrial 7 Lawn and garden only 10 Monitoring well

Was a chemical/bacteriological sample submitted to Department? Yes No X; If yes, mo/day/yr sample was submitted

Water Well Disinfected? Yes No X

5 TYPE OF BLANK CASING USED:

1 Steel 3 RMP (SR)
2 PVC 4 ABS

5 Wrought iron 8 Concrete tile

CASING JOINTS: Glued Clamped

6 Asbestos-Cement 9 Other (specify below)

Welded

7 Fiberglass

Threaded

Flush

Blank casing diameter 2 in. to ft., Dia in. to ft., Dia in. to ft.

Casing height above land surface Flush 0 in. weight 703 lbs./ft. Wall thickness or gauge No. 154

TYPE OF SCREEN OR PERFORATION MATERIAL:

1 Steel 3 Stainless steel 5 Fiberglass 8 RMP (SR)
2 Brass 4 Galvanized steel 6 Concrete tile 9 ABS

10 Asbestos-cement

5 Gauzed wrapped

8 Saw cut

11 None (open hole)

6 Wire wrapped

9 Drilled holes

7 Torch cut

10 Other (specify)

SCREEN-PERFORATED INTERVALS: From 12 ft. to 22 ft., From ft. to ft.

From ft. to ft., From ft. to ft.

GRAVEL PACK INTERVALS: From 11 ft. to 22 ft., From ft. to ft.

From ft. to ft., From ft. to ft.

6 GROUT MATERIAL: 1 Neat cement 2 Cement grout 3 Bentonite 4 Other

Grout Intervals: From 11 ft. to 2 ft., From ft. to ft., From ft. to ft.

What is the nearest source of possible contamination:

1 Septic tank 4 Lateral lines 7 Pit privy
2 Sewer lines 5 Cess pool 8 Sewage lagoon
3 Watertight sewer lines 6 Seepage pit 9 Feedyard

10 Livestock pens

14 Abandoned water well

11 Fuel storage

15 Oil well/Gas well

12 Fertilizer storage

16 Other (specify below)

13 Insecticide storage

How many feet? 400

Direction from well? West

FROM TO LITHOLOGIC LOG FROM TO PLUGGING INTERVALS

0.0 13.0 Clay, brown
13.0 18.5 Clay, brown, Salty
18.5 22.0 Silt, tan, clayey

7 CONTRACTOR'S OR LANDOWNER'S CERTIFICATION: This water well was (1) constructed (2) reconstructed, or (3) plugged under my jurisdiction and was completed on (mo/day/year) 1-5-94 and this record is true to the best of my knowledge and belief. Kansas

Water Well Contractor's License No. 531 This Water Well Record was completed on (mo/day/yr) 1-7-99

under the business name of GSI by (signature) Allison Irwin