

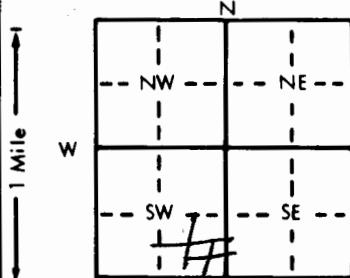
1 LOCATION OF WATER WELL:	Fraction County: <i>Butler</i>	Section Number SE $\frac{1}{4}$ SW $\frac{1}{4}$	Township Number T 27 S	Range Number R 4 E
---------------------------	-----------------------------------	---	---------------------------	-----------------------

Distance and direction from nearest town or city street address of well if located within city?

Augusta

2 WATER WELL OWNER:	<i>SIGMA-TEK</i>	Wichita Kan
RR#, St. Address, Box #	<i>1326 South Walnut Street</i>	Board of Agriculture, Division of Water Resources
City, State, ZIP Code	<i>67213</i>	Application Number:

3 LOCATE WELL'S LOCATION WITH AN "X" IN SECTION BOX:	4 DEPTH OF COMPLETED WELL ft. ELEVATION:
--	--

Depth(s) Groundwater Encountered 1. *40* ft. 2. *95* ft. 3. ft.WELL'S STATIC WATER LEVEL *10* ft. below land surface measured on mo/day/yr

Pump test data: Well water was ft. after hours pumping gpm

Est. Yield *15* gpm Well water was ft. after hours pumping gpmBore Hole Diameter *8 1/2* in. to ft. and in. to ft.

WELL WATER TO BE USED AS: 5 Public water supply 8 Air conditioning 11 Injection well

1 Domestic 3 Feedlot 6 Oil field water supply 9 Dewatering 12 Other (Specify below)

2 Irrigation 4 Industrial 7 Lawn and garden only 10 Observation well

Was a chemical/bacteriological sample submitted to Department? Yes No If yes, mo/day/yr sample was submitted

Water Well Disinfected? Yes No

5 TYPE OF BLANK CASING USED:	5 Wrought iron	8 Concrete tile	CASING JOINTS: Glued <input checked="" type="checkbox"/> Clamped
------------------------------	----------------	-----------------	--

1 Steel *3* RMP (SR)2 PVC *4* ABSBlank casing diameter *5* in. to *30* ft., Dia *50* in. to *80* ft., Dia *120* in. to *145* ft.Casing height above land surface *18* in., weight *200* lbs./ft. Wall thickness or gauge No. *12 1/4*

TYPE OF SCREEN OR PERFORATION MATERIAL:	7 PVC	10 Asbestos-cement
---	-------	--------------------

1 Steel 3 Stainless steel 5 Fiberglass *8* RMP (SR)

2 Brass 4 Galvanized steel 6 Concrete tile 9 ABS

5 Gauzed wrapped 8 Saw cut 11 Other (specify)

6 Wire wrapped 9 Drilled holes 12 None used (open hole)

7 Torch cut 10 Other (specify) 11 None (open hole)

SCREEN OR PERFORATION OPENINGS ARE:

1 Continuous slot 3 Mill slot 7 Gauzed wrapped 10 Asbestos-cement

2 Louvered shutter 4 Key punched 6 Wire wrapped 11 Other (specify)

SCREEN-PERFORATED INTERVALS: From *30* ft. to *50* ft., From *50* ft. to *120* ft.From *80* ft. to *120* ft., From *120* ft. to *145* ft.

GRAVEL PACK INTERVALS: From ft. to ft., From ft. to ft.

From ft. to ft., From ft. to ft.

6 GROUT MATERIAL: 1 Neat cement 2 Cement grout 3 Bentonite 4 Other

Grout Intervals: From *3* ft. to *130* ft., From ft. to ft., From ft. to ft.

What is the nearest source of possible contamination:

1 Septic tank 4 Lateral lines 7 Pit privy 10 Livestock pens 14 Abandoned water well

2 Sewer lines 5 Cess pool 8 Sewage lagoon 11 Fuel storage 15 Oil well/Gas well

3 Watertight sewer lines 6 Seepage pit 9 Feedyard 12 Fertilizer storage 16 Other (specify below)

Direction from well? *E* How many feet? *200*

FROM TO LITHOLOGIC LOG FROM TO LITHOLOGIC LOG

0 3 Soil

3 10 Clay - Red

10 25 Clay - Gray

25 70 Shale

70 120 Lime

120 145 Shale

7 CONTRACTOR'S OR LANDOWNER'S CERTIFICATION: This water well was *1* constructed, *2* reconstructed, or *3* plugged under my jurisdiction and was completed on (mo/day/year) *10/7/85* and this record is true to the best of my knowledge and belief. KansasWater Well Contractor's License No. *254* This Water Well Record was completed on (mo/day/yr) *1/19/86* under the business name of *Winter Well Drill* by (signature) *Charles Winter*

INSTRUCTIONS: Use typewriter or ball point pen, PLEASE PRESS FIRMLY and PRINT clearly. Please fill in blanks, underline or circle the correct answers. Send top three copies to Kansas Department of Health and Environment, Division of Environment, Environmental Geology Section, Topeka, KS 66620. Send one to WATER WELL OWNER and retain one for your records.