

1 LOCATION OF WATER WELL:

Fraction

NE $\frac{1}{4}$ N E $\frac{1}{4}$ SW $\frac{1}{4}$

Section Number

23

Township Number

T 27 S

Range Number

R 40 E

County: Butler
Distance and direction from nearest town or city street address of well if located within city?

Augusta

2 WATER WELL OWNER:

Mark Olmstead

67010

RR#, St. Address, Box #:


1001 Wirth Augusta Kan

Board of Agriculture, Division of Water Resources

City, State, ZIP Code:

Application Number:

3 LOCATE WELL'S LOCATION WITH AN "X" IN SECTION BOX:

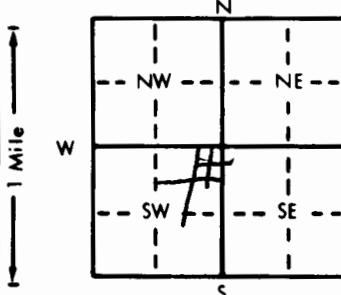

4 DEPTH OF COMPLETED WELL:

165 ft. ELEVATION:

Depth(s) Groundwater Encountered 1 90 ft. 2. ft. 3. ft.

WELL'S STATIC WATER LEVEL 20 ft. below land surface measured on mo/day/yr

Pump test data: Well water was ft. after hours pumping gpm

Est. Yield 360 gpm Well water was ft. after hours pumping gpm

Bore Hole Diameter 8 1/2 in. to ft. and in. to ft.

WELL WATER TO BE USED AS: 5 Public water supply 8 Air conditioning 11 Injection well

1 Domestic 3 Feedlot 6 Oil field water supply 9 Dewatering 12 Other (Specify below)

2 Irrigation 4 Industrial 7 Lawn and garden only 10 Observation well

Was a chemical/bacteriological sample submitted to Department? Yes No If yes, mo/day/yr sample was submitted Water Well Disinfected? Yes No

5 TYPE OF BLANK CASING USED:

1 Steel (3) RMP (SR)
2 PVC 4 ABS

5 Wrought iron

8 Concrete tile

CASING JOINTS: Glued

X Clamped

6 Asbestos-Cement 9 Other (specify below)

7 Fiberglass

Welded

Threaded

Blank casing diameter 3 in. to 30 ft. Dia 50 in. to 100 ft. Dia in. to ft.

Casing height above land surface 18 in. weight 200 lbs./ft. Wall thickness or gauge No. 12 1/4

TYPE OF SCREEN OR PERFORATION MATERIAL:

1 Steel 3 Stainless steel 5 Fiberglass 7 PVC 10 Asbestos-cement
2 Brass 4 Galvanized steel 6 Concrete tile 8 RMP (SR) 11 Other (specify)
3 ABS 9 ABS

SCREEN OR PERFORATION OPENINGS ARE:

1 Continuous slot 3 Mill slot 5 Gauzed wrapped 8 Saw cut 11 None (open hole)
2 Louvered shutter 4 Key punched 6 Wire wrapped 9 Drilled holes
7 Torch cut 10 Other (specify)

SCREEN-PERFORATED INTERVALS: From 30 ft. to 50 ft. From 100 ft. to 165 ft.

From ft. to ft. From ft. to ft. From ft. to ft.

GRAVEL PACK INTERVALS: From ft. to ft. From ft. to ft. From ft. to ft.

From ft. to ft. From ft. to ft. From ft. to ft.

6 GROUT MATERIAL: 1 Neat cement 2 Cement grout 3 Bentonite 4 Other

Grout Intervals: From 0 ft. to 200 ft., From ft. to ft., From ft. to ft., From ft. to ft.

What is the nearest source of possible contamination: 10 Livestock pens 14 Abandoned water well

1 Septic tank 4 Lateral lines 7 Pit privy 11 Fuel storage 15 Oil well/Gas well
2 Sewer lines 5 Cess pool 8 Sewage lagoon 12 Fertilizer storage 16 Other (specify below)

3 Watertight sewer lines 6 Seepage pit 9 Feedyard 13 Insecticide storage

Direction from well? How many feet? 100

FROM TO LITHOLOGIC LOG FROM TO LITHOLOGIC LOG

0 2 Soil

2 4 Rock

4 8 Clay

8 10 Shale

10 35 Shale

35 95 Lime

95 165 Lime & Shale

7 CONTRACTOR'S OR LANDOWNER'S CERTIFICATION: This water well was (1) constructed, (2) reconstructed, or (3) plugged under my jurisdiction and was completed on (mo/day/year) 6/16/87 and this record is true to the best of my knowledge and belief. Kansas

Water Well Contractor's License No. 25 This Water Well Record was completed on (mo/day/yr) 6/16/87 by (signature) Charles Winter

INSTRUCTIONS: Use typewriter or ball point pen. PLEASE PRESS FIRMLY and PRINT clearly. Please fill in blanks, underline or circle the correct answers. Send top three copies to Kansas Department of Health and Environment, Bureau of Water Protection, Topeka, Kansas 66620-7320, Telephone: 913-862-9360. Send one to WATER WELL OWNER and retain one for your records.