

1 LOCATION OF WATER WELL:

Fraction

NW $\frac{1}{4}$ SW $\frac{1}{4}$ SE $\frac{1}{4}$

Section Number

27

Township Number

T

27

S

Range Number

R

4

NW

County: Butler
Distance and direction from nearest town or city street address of well if located within city?

located near SW portion Augusta, KS 2400' South of 7th & State

2 WATER WELL OWNER: mobil Oil Corporation


RR#, St. Address, Box #: P.O. Box 246, Gulf States Rd.

City, State, ZIP Code: Beaumont, TX 77704-0246

Board of Agriculture, Division of Water Resources

Application Number:

3 LOCATE WELL'S LOCATION WITH AN "X" IN SECTION BOX:

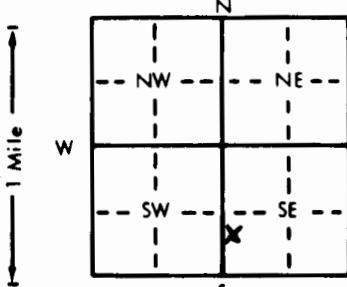

4 DEPTH OF COMPLETED WELL: 33.5 ft. ELEVATION: 1220

Depth(s) Groundwater Encountered 17.0 ft. 2. ft. 3. ft.

WELL'S STATIC WATER LEVEL ft. below land surface measured on mo/day/yr

Pump test data: Well water was ft. after hours pumping gpm

Est. Yield gpm: Well water was ft. after hours pumping gpm

Bore Hole Diameter 12.0 in. to 34.0 ft. and in. to ft.

WELL WATER TO BE USED AS: 5 Public water supply 8 Air conditioning 11 Injection well

1 Domestic 3 Feedlot 6 Oil field water supply 9 Dewatering 12 Other (Specify below)

2 Irrigation 4 Industrial 7 Lawn and garden only 10 Observation well

Was a chemical/bacteriological sample submitted to Department? Yes No; If yes, mo/day/yr sample was submitted

Water Well Disinfected? Yes No X

5 TYPE OF BLANK CASING USED:

1 Steel 3 RMP (SR)
2 PVC 4 ABS

5 Wrought iron

8 Concrete tile

CASING JOINTS: Glued Clamped

6 Asbestos-Cement 9 Other (specify below)

Welded

7 Fiberglass

Threaded

Blank casing diameter 4 in. to 8.0 ft. Dia. in. to ft. Dia. in. to ft.

Casing height above land surface 24 in. weight lbs./ft. Wall thickness or gauge No. Schedule 40

TYPE OF SCREEN OR PERFORATION MATERIAL:

1 Steel 3 Stainless steel 5 Fiberglass 8 RMP (SR)
2 Brass 4 Galvanized steel 6 Concrete tile 9 ABS
1 Continuous slot 3 Mill slot 5 Gauzed wrapped 8 Saw cut 11 None (open hole)
2 Louvered shutter 4 Key punched 6 Wire wrapped 9 Drilled holes
7 Torch cut 10 Other (specify)

7 PVC

10 Asbestos-cement

SCREEN OR PERFORATION OPENINGS ARE:

1 Continuous slot 3 Mill slot
2 Louvered shutter 4 Key punched

5 Gauzed wrapped 8 Saw cut 11 None (open hole)

6 Wire wrapped 9 Drilled holes

7 Torch cut 10 Other (specify)

SCREEN-PERFORATED INTERVALS: From 8.0 ft. to 33.0 ft. From ft. to ft. From ft. to ft.

From ft. to ft. From ft. to ft. From ft. to ft.

GRAVEL PACK INTERVALS: From 6.7 ft. to 33.5 ft. From ft. to ft. From ft. to ft.

From ft. to ft. From ft. to ft. From ft. to ft.

6 GROUT MATERIAL: 1 Neat cement 2 Cement grout 3 Bentonite 4 Other

Grout Intervals: From surface ft. to 5.0 ft. From ft. to ft. From ft. to ft. From ft. to ft.

What is the nearest source of possible contamination:

1 Septic tank 4 Lateral lines 7 Pit privy 10 Livestock pens 14 Abandoned water well
2 Sewer lines 5 Cess pool 8 Sewage lagoon 11 Fuel storage 15 Oil well/Gas well
3 Watertight sewer lines 6 Seepage pit 9 Feedyard 12 Fertilizer storage 16 Other (specify below)Oil Refinery
1000'

Direction from well?

FROM TO LITHOLOGIC LOG FROM TO LITHOLOGIC LOG

0 4.5 Dark brown Fill w/ concrete

4.5 30.0 Light brown Silty Clay

becoming dk brown & gray
at ~6.0', becoming tan
at ~24.0'

30.0 31.8 Tan Silty Clay w/trace of fine sand

31.8 34.0 Dark gray Silty Clay w/ trace of fine sand and layer of medium sand

7 CONTRACTOR'S OR LANDOWNER'S CERTIFICATION: This water well was (1) constructed (2) reconstructed, or (3) plugged under my jurisdiction and was completed on (mo/day/year) 5/21/87 and this record is true to the best of my knowledge and belief. Kansas

Water Well Contractor's License No. 399 This Water Well Record was completed on (mo/day/yr) 6/3/87

under the business name of Woodward - Clyde Consultants by (signature) *Robert L. McNeil*

INSTRUCTIONS: Use typewriter or ball point pen. PLEASE PRESS FIRMLY and PRINT clearly. Please fill in blanks, underline or circle the correct answers. Send top three copies to Kansas Department of Health and Environment, Bureau of Water Protection, Topeka, Kansas 66620-7320, Telephone: 913-862-9360. Send one to WATER WELL OWNER and retain one for your records.