

## 1 LOCATION OF WATER WELL:

Fraction

NC  $\frac{1}{4}$  SW  $\frac{1}{4}$  SW  $\frac{1}{4}$ 

Section Number

27

Township Number

T 27 S

Range Number

R 4

CEN

County: Butler  
Distance and direction from nearest town or city street address of well if located within city?

See #2


## 2 WATER WELL OWNER: Williams Pipeline Co.

RR#, St. Address, Box #: 2nd & OAK  
City, State, ZIP Code: Augusta, KS

Board of Agriculture, Division of Water Resources

Application Number:

## 3 LOCATE WELL'S LOCATION WITH AN "X" IN SECTION BOX:

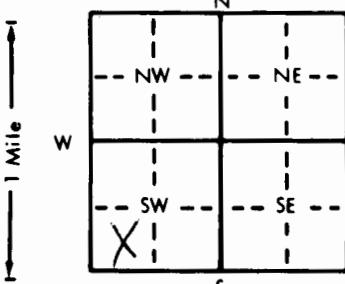

## 4 DEPTH OF COMPLETED WELL: 22 ft. ELEVATION: .....

Depth(s) Groundwater Encountered 1 ft. 2 ft. 3 ft. ft.

WELL'S STATIC WATER LEVEL 22: 15 ft. below land surface measured on mo/day/yr 5-3-89

Pump test data: Well water was ft. after hours pumping gpm

Est. Yield gpm: Well water was ft. after hours pumping gpm

Bore Hole Diameter 8 in. to ft. and in. to ft.

WELL WATER TO BE USED AS: 5 Public water supply 8 Air conditioning 11 Injection well

1 Domestic 3 Feedlot 6 Oil field water supply 9 Dewatering 12 Other (Specify below)

2 Irrigation 4 Industrial 7 Lawn and garden only 10 Observation well

Was a chemical/bacteriological sample submitted to Department? Yes No X; If yes, mo/day/yr sample was submitted

Water Well Disinfected? Yes No X

## 5 TYPE OF BLANK CASING USED:

1 Steel 3 RMP (SR)

5 Wrought iron

8 Concrete tile

CASING JOINTS: Glued Clamped

2 PVC

4 ABS

6 Asbestos-Cement

7 Fiberglass

9 Other (specify below)

Welded

Threaded X

Blank casing diameter 2 in. to ft. Dia in. to ft. Dia in. to ft.

Casing height above land surface 1: 94 ft. weight lbs./ft. Wall thickness or gauge No. SCH 40

## TYPE OF SCREEN OR PERFORATION MATERIAL:

1 Steel 3 Stainless steel

5 Fiberglass

7 PVC

10 Asbestos-cement

2 Brass 4 Galvanized steel

6 Concrete tile

8 RMP (SR)

11 Other (specify)

6 ABS 9 ABS 12 None used (open hole)

## SCREEN OR PERFORATION OPENINGS ARE:

1 Continuous slot 3 Mill slot

5 Gauzed wrapped

8 Saw cut

11 None (open hole)

2 Louvered shutter 4 Key punched

6 Wire wrapped

9 Drilled holes

SCREEN-PERFORATED INTERVALS: From 12 ft. to 22 ft. From ft. to ft.

7 Torch cut

10 Other (specify)

From ft. to ft. From ft. to ft. From ft. to ft.

GRAVEL PACK INTERVALS: From 10 ft. to 27 ft. From ft. to ft. From ft. to ft.

From ft. to ft.

From ft. to ft.

ft. to ft.

6 GROUT MATERIAL: 1 Neat cement 2 Cement grout 3 Bentonite 4 Other

Grout Intervals: From 0 ft. to 7 ft. From 7 ft. to 10 ft. From ft. to ft.

What is the nearest source of possible contamination:

1 Septic tank 4 Lateral lines

7 Pit privy

10 Livestock pens

14 Abandoned water well

2 Sewer lines 5 Cess pool

8 Sewage lagoon

11 Fuel storage

15 Oil well/Gas well

3 Watertight sewer lines 6 Seepage pit

9 Feedyard

12 Fertilizer storage

16 Other (specify below)

Direction from well?

All

How many feet?

FROM TO LITHOLOGIC LOG FROM TO LITHOLOGIC LOG

Geraghty &amp; Miller # 6M25


## 7 CONTRACTOR'S OR LANDOWNER'S CERTIFICATION: This water well was (1) constructed, (2) reconstructed, or (3) plugged under my jurisdiction and was completed on (mo/day/year) 5-2-89 and this record is true to the best of my knowledge and belief. Kansas

Water Well Contractor's License No. 468 This Water Well Record was completed on (mo/day/yr) \_\_\_\_\_

under the business name of J &amp; R Drilling Services Inc. by (signature) Ray Coons

INSTRUCTIONS: Use typewriter or ball point pen. PLEASE PRESS FIRMLY and PRINT clearly. Please fill in blanks, underline or circle the correct answers. Send top three copies to Kansas Department of Health and Environment, Bureau of Water Protection, Topeka, Kansas 66620-7320, Telephone: 913-862-9360. Send one to WATER WELL OWNER and retain one for your records.

## WELL CONSTRUCTION LOG

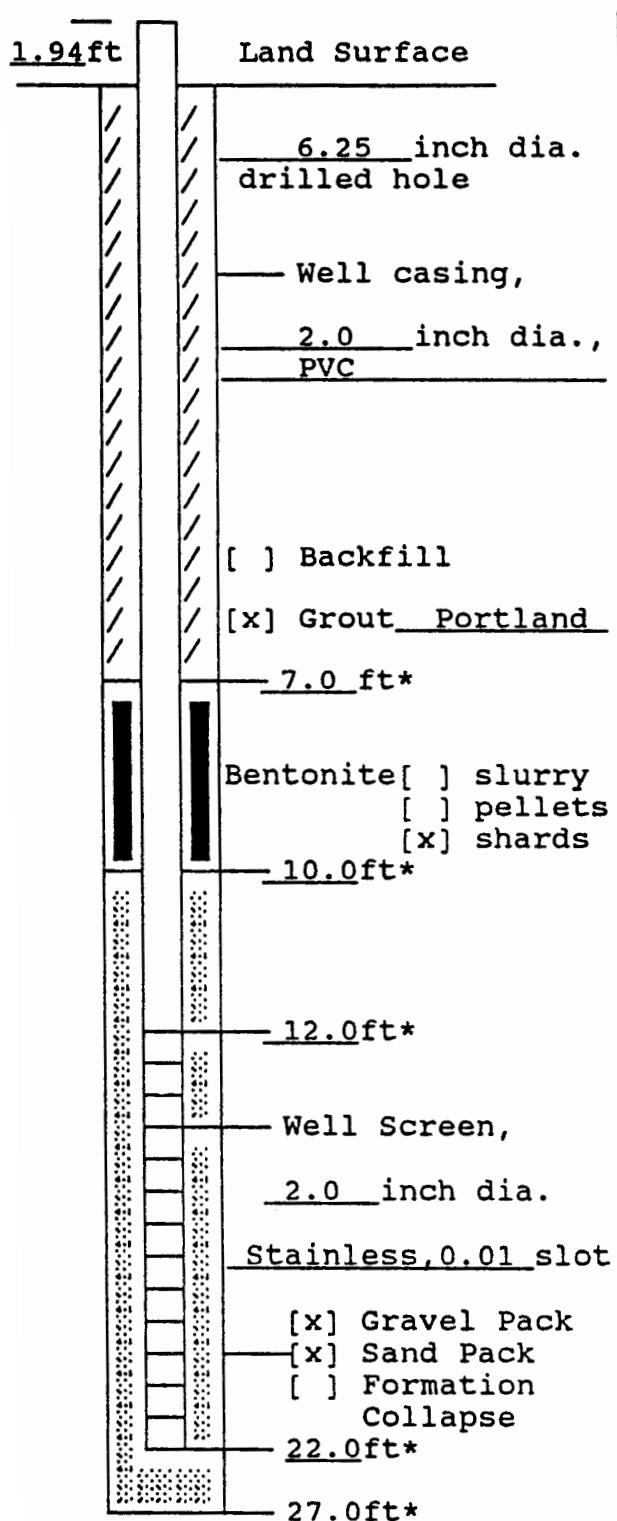

Measuring Point is Top of Well  
Casing Unless Otherwise Noted.

NA = Not Applicable

\* = Depth below land surface

Project OK1333RC01 Well GM2S  
Town/City Augusta  
County Butler State KS  
Permit No. NA  
Measuring Point(\*)Elevation  
[x] surveyed  
ft AMSL [ ] estimated  
(\*)Measuring Point is top of casing

Installation Dates(s) 5/2/89  
Drilling Method Hollow Stem Auger  
Drilling Contractor J&R Drilling  
Drilling Fluid NA

Development Techniques(s) and Dates(s)  
Bailing; 5/5/89

Fluid Loss During Drilling NA gal  
Water Removed During Dev. 7.0 gal  
Static Depth to Water 22.15 ft below MP  
Pumping Depth to Water NA ft below MP  
Pumping Duration NA hours  
Yield NA gpm Date                     
Specific Capacity NA gpm/ft  
Well Purpose Ground-water monitoring

Remarks                   

Bentonite plug hydrated w/ distilled water.

Prepared by JPS

GERAGHTY &  
MILLER, INC.

SAMPLE/CORE LOG

Boring/Well GM2S Project/No. OK1333RC01 Page 1 of 1

Site Augusta, KS Drilling Started 10:25 Drilling Completed 11:40

Total Depth Drilled 27.0 feet Hole Diameter 6.25 inches Type of Sample/  
Coring Device Split Spoon

Length and Diameter of Coring Device 5' x 3.75" Sampling Interval Continuous feet

Land-Surface Elev. \_\_\_\_\_ feet [x] Surveyed [ ] Estimated Datum AMSL

Drilling Fluid Used None Drilling Method H.S. Auger

Drilling Contractor J&R Drilling Driller John Coons Helper Greg

Prepared By JPS Hammer Weight NA Hammer Drop NA inches

Smpl/Core	Core	Time/Hydraulic
Depth (ft BLS)	Rec. (ft)	Press. or Blows/6 in.
From	To	

Sample/Core Description

0.0	4.0	4.0	03	SILTY CLAY- (topsoil fill), drk. brn., pliable, few organics, sl. damp, no odor.
4.0	5.0			SILTY CLAY- brn. abund. white granular material,
		2.8		Fe oxide staining, sl. pliable, no odor.
5.0	9.0		01	SLUDGE/CLAY- blk., v. pliable, sl. damp, hydrocarbon odor, <HNU = 5-10 ppm>.
9.0	14.0	4.0		CLAY- blk., stained w/ hydrocarbons, silty, pliable, damp w/ hydrocarbons, hydrocarbon odor, <HNU = 100-140 ppm>.
14.0	19.0	4.0		CLAY- drk. grey, sl. silty, sl. pliable, dense, sl. damp, v. sl. hydrocarbon odor.
19.0	24.0	5.0		CLAY- drk. grey, sl. silty, dense, sl. damp, few blk. organics, hydrocarbon odor.
24.0	25.0	1.0		CLAY- " " "
25.0	27.0	2.0	05	SAND- lt. grey, v.f. grained, silty, clayey, poorly sorted, sl. hydrocarbon odor, wet.