

Range Number

Township Number

R 4 E

1 LOCATION OF WATER WELL:

Fraction

NE $\frac{1}{4}$ NE $\frac{1}{4}$ NE $\frac{1}{4}$

Section Number

27

Township Number

T

27

S

R 4 E

County: Butler

Distance and direction from nearest town or city street address of well if located within city?

5th & School

2 WATER WELL OWNER:


City of Augusta

5th & School Box 489
Augusta, KS 67018Board of Agriculture, Division of Water Resources
Application Number:3 LOCATE WELL'S LOCATION WITH
AN "X" IN SECTION BOX:

4 DEPTH OF COMPLETED WELL

17.0

ft. ELEVATION:

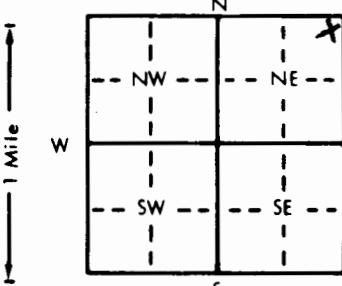

Depth(s) Groundwater Encountered

19.0

ft. 2

ft. 3

WELL'S STATIC WATER LEVEL

9.72

ft. below land surface measured on mo/day/yr

Pump test data: Well water was ft. after hours pumping gpm

Est. Yield gpm: Well water was ft. after hours pumping gpm

Bore Hole Diameter in. to ft., and in. to ft.

WELL WATER TO BE USED AS:

5 Public water supply

8 Air conditioning

11 Injection well

1 Domestic

3 Feedlot

6 Oil field water supply

9 Dewatering

12 Other (Specify below)

2 Irrigation

4 Industrial

7 Lawn and garden only

10 Monitoring well

Was a chemical/bacteriological sample submitted to Department? Yes No X; If yes, mo/day/yr sample was submitted

Water Well Disinfected? Yes

No X

5 TYPE OF BLANK CASING USED:

5 Wrought iron

CASING JOINTS: Glued Clamped

1 Steel

3 RMP (SR)

6 Asbestos-Cement

Welded

2 PVC

4 ABS

7 Fiberglass

Threaded

Blank casing diameter in. to ft., Dia in. to ft., Dia in. to ft.

Casing height above land surface in., weight lbs./ft. Wall thickness or gauge No. Sch. 40

TYPE OF SCREEN OR PERFORATION MATERIAL:

1 Steel

3 Stainless steel

5 Fiberglass

8 Saw cut

11 None (open hole)

2 Brass

4 Galvanized steel

6 Concrete tile

9 Drilled holes

10 Asbestos-cement

3 Mill slot

4 Key punched

7 Gauzed wrapped

10 Other (specify)

11 Other (specify)

SCREEN OR PERFORATION OPENINGS ARE:

1 Continuous slot

3 Mill slot

6 Wire wrapped

11 Other (specify)

2 Louvered shutter

4 Key punched

7 Torch cut

12 None used (open hole)

SCREEN-PERFORATED INTERVALS: From

ft. to ft.

ft., From ft. to ft.

ft.

From

ft. to ft.

ft., From ft. to ft.

ft.

GRAVEL PACK INTERVALS: From

ft. to ft.

ft., From ft. to ft.

ft.

From

ft. to ft.

ft., From ft. to ft.

ft.

6 GROUT MATERIAL:

1 Neat cement

2 Cement grout

8 Bentonite

4 Other

Grout Intervals: From ft. to ft., From ft. to ft., From ft. to ft.

What is the nearest source of possible contamination:

1 Septic tank

4 Lateral lines

7 Pit privy

10 Livestock pens

14 Abandoned water well

2 Sewer lines

5 Cess pool

8 Sewage lagoon

11 Fuel storage

15 Oil well/Gas well

3 Watertight sewer lines

6 Seepage pit

9 Feedyard

12 Fertilizer storage

16 Other (specify below)

17 How many feet?

30' West

FROM TO LITHOLOGIC LOG FROM TO PLUGGING INTERVALS

0 17 Silty clay, Brown, saturated

7 CONTRACTOR'S OR LANDOWNER'S CERTIFICATION: This water well was (1) constructed, (2) reconstructed, or (3) plugged under my jurisdiction and was completed on (mo/day/year) 12/19/90 and this record is true to the best of my knowledge and belief. Kansas

Water Well Contractor's License No. 324 This Water Well Record was completed on (mo/day/year) 12/25/90 by (signature) Richard J. Elgin