


|                           |                                                    |                |                 |              |
|---------------------------|----------------------------------------------------|----------------|-----------------|--------------|
| 1 LOCATION OF WATER WELL: | Fraction                                           | Section Number | Township Number | Range Number |
| County: <b>Butler</b>     | SW $\frac{1}{4}$ SW $\frac{1}{4}$ SW $\frac{1}{4}$ | 27             | T 27 S          | R 4 E/W      |

Distance and direction from nearest town or city street address of well if located within city?  
505' East of West Fence & 555' North of South Fence For the Former Augusta Refinery MW/GM-8

|   |                           |                                   |                                                   |
|---|---------------------------|-----------------------------------|---------------------------------------------------|
| 2 | WATER WELL OWNER:         | Williams Pipeline Company         | 01928035                                          |
|   | RR#, St. Address, Box # : | 10200 West 75th Street, Suite 270 | Board of Agriculture, Division of Water Resources |
|   | City, State, ZIP Code :   | Shawnee Mission, KS 66212         | Application Number:                               |

|   |                                                    |   |                                   |                                                 |
|---|----------------------------------------------------|---|-----------------------------------|-------------------------------------------------|
| 3 | LOCATE WELL'S LOCATION WITH AN "X" IN SECTION BOX: | 4 | DEPTH OF COMPLETED WELL..... 34.5 | ft. ELEVATION: Approximate Surface Elev: 1219.2 |
|---|----------------------------------------------------|---|-----------------------------------|-------------------------------------------------|

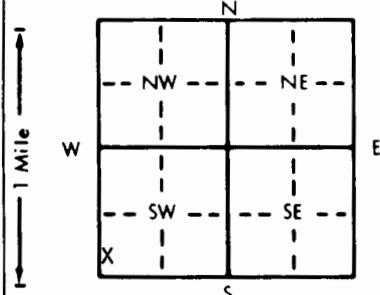

4 DEPTH OF COMPLETED WELL 34.5 ft. ELEVATION: Approximate Surface Elev: 1219.2  
 Depth(s) Groundwater Encountered 199 ft. 2. ft. 3. ft.  
 WELL'S STATIC WATER LEVEL 199 ft. below land surface measured on mo/day/yr  
 Pump test data: Well water was ft. after hours pumping gpm  
 Est. Yield N/A gpm: Well water was ft. after hours pumping gpm  
 Bore Hole Diameter 7.25 in. to 34.5 ft., and in. to ft.  
 WELL WATER TO BE USED AS:  
 1 Domestic 3 Feedlot 6 Oil field water supply 9 Dewatering 12 Other (Specify below)  
 2 Irrigation 4 Industrial 7 Lawn and garden only 10 Monitoring well  
 Was a chemical/bacteriological sample submitted to Department? Yes No X; If yes, mo/day/yr sample was submitted  
 Water Well Disinfected? Yes No X

|                              |            |                   |                         |                                                  |  |
|------------------------------|------------|-------------------|-------------------------|--------------------------------------------------|--|
| 5 TYPE OF BLANK CASING USED: |            | 5 Wrought iron    | 8 Concrete tile         | CASING JOINTS: Glued . . . . . Clamped . . . . . |  |
| 1 Steel                      | 3 RMP (SR) | 6 Asbestos-Cement | 9 Other (specify below) | Welded . . . . .                                 |  |
| 2 PVC                        | 4 ABS      | 7 Fiberglass      | Stainless Steel         | Threaded . . . . . X                             |  |

Blank casing diameter . . . . . 2 . . . . . in. to . . . . . 29 . . . . . ft., Dia . . . . . in. to . . . . . ft., Dia . . . . . in. to . . . . . ft.

Casing height above land surface . . . . . 30 . . . . . in., weight . . . . . lbs./ft. Wall thickness or gauge No. . . . .

|                                         |                    |            |                              |
|-----------------------------------------|--------------------|------------|------------------------------|
| TYPE OF SCREEN OR PERFORATION MATERIAL: |                    | 7 PVC      | 10 Asbestos-cement           |
| 1 Steel                                 | 3 Stainless steel  | 8 RMP (SR) | 11 Other (specify) . . . . . |
| 2 Brass                                 | 4 Galvanized steel | 9 ABS      | 12 None used (open hole)     |

SCREEN OR PERFORATION OPENINGS ARE:

|                    |               |                  |                              |                     |
|--------------------|---------------|------------------|------------------------------|---------------------|
| 1 Continuous slot  | 3 Mill slot   | 5 Gauzed wrapped | 8 Saw cut                    | 11 None (open hole) |
| 2 Louvered shutter | 4 Key punched | 6 Wire wrapped   | 9 Drilled holes              |                     |
|                    |               | 7 Torch cut      | 10 Other (specify) . . . . . |                     |

SCREEN-PERFORATED INTERVALS: From . . . . . 29 . . . . . ft. to . . . . . 34 . . . . . ft., From . . . . . ft. to . . . . . ft., From . . . . . ft. to . . . . . ft.

GRAVEL PACK INTERVALS: From . . . . . 29 . . . . . ft. to . . . . . 34.5 . . . . . ft., From . . . . . ft. to . . . . . ft., From . . . . . ft. to . . . . . ft.

6 GROUT MATERIAL: 1 Neat cement 2 Cement grout 3 Bentonite 4 Other  
Grout Intervals: From 0 ft. to 0.24 ft., From 24 ft. to 27 ft., From ft. to ft.  
What is the nearest source of possible contamination:  
1 Septic tank 4 Lateral lines 7 Pit privy 10 Livestock pens 14 Abandoned water well  
2 Sewer lines 5 Cess pool 8 Sewage lagoon 11 Fuel storage 15 Oil well/Gas well  
3 Watertight sewer lines 6 Seepage pit 9 Feedyard 12 Fertilizer storage 16 Other (specify below)  
13 Insecticide storage

[illegible]

7 CONTRACTOR'S OR LANDOWNER'S CERTIFICATION: This water well was (1) constructed, (2) reconstructed, or (3) plugged under my jurisdiction and was completed on (mo/day/year) 04/23/93 and this record is true to the best of my knowledge and belief. Kansas Water Well Contractor's License No. 416 This Water Well Record was completed on (mo/day/yr) 5/3-93 under the business name of Terracon Consultants, Inc. by (signature) 