USE TYPEWRITER OR BALL POINT PEN-PRESS FIRMLY, PRINT CLEARLY.

WATER WELL RECORD
KSA 82a-1201-1215

Kansas Department of Health and Environment-Division of Environment
(Water well Contractors)
Topeka, Kansas 66620

X. Location of well:	County	Fraction	Section number	Township number	Range number
	Butler	SE 1/4 SE 1/4 NW 1/4	31	T 27 S	R 4 E/W

X. Distance and direction from nearest town or city: 3 N 1 1/2 W Towanda
Street address of well location if in city:

3. Owner of well: Wallace Johnson
R.R. or street: RT Towanda
City, state, zip code:

4. Locate with "X" in section below:

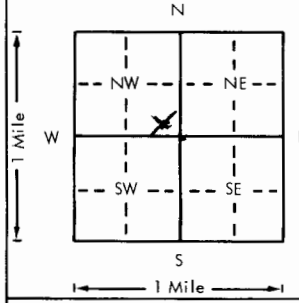

Sketch map:

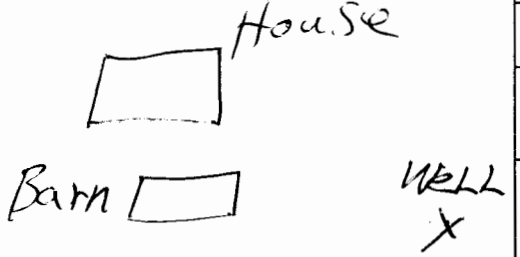

6. Bore hole dia. 7 in. Completion date 3/8/79
Well depth 100 ft.

7. X Cable tool __ Rotary __ Driven __ Dug
__ Hollow rod __ Jetted __ Bored __ Reverse rotary

8. Use: X Domestic __ Public supply __ Industry
__ Irrigation __ Air conditioning __ Stock
__ Lawn __ Oil field water __ Other

9. Casing: Material Plas Height: Above or below
Threaded __ Welded X Surface 24 in.
RMP X PVC __ Weight 100 lbs./ft.
Dia. 5 in. to 100 ft. depth Wall Thickness: inches or
Dia. __ in. to __ ft. depth gage No. 175

5. Type and color of material	From	To
Soil	0	5
~~Clay~~ Rock	5	20
Clay	20	50
Lime	50	65
Sandy Lime	65	85
Shale	85	100

(Use a second sheet if needed)

10. Screen: Manufacturer's name Sanflower
Type 100 Dia. 5
Slot/gauze 1/16 Length 20
Set between 75 ft. and 95 ft.
ft. and ft.
Gravel pack? Yes Size range of material 5/8

11. Static water level: mo./day/yr.
X 20 ft. below land surface Date X 3/8/79

12. Pumping level below land surfaces:
30 ft. after 1 hrs. pumping g.p.m.
ft. after hrs. pumping g.p.m.
Estimated maximum yield 50 g.p.m.

13. Water sample submitted: mo./day/yr.
__ Yes NC No Date

14. Well head completion:
__ Pitless adapter Inches above grade

15. Well grouted? Yes
With: X Neat cement __ Bentonite __ Concrete
Depth: From 0 ft. to 10 ft.

16. Nearest source of possible contamination:
ft. 200 Direction ~~N~~ W Type Barn
Well disinfected upon completion? X Yes __ No

17. Pump: X Not installed
Manufacturer's name
Model number HP Volts
Length of drop pipe ft. capacity g.p.m.
Type:
__ Submersible __ Turbine
__ Jet __ Reciprocating
__ Centrifugal __ Other

18. Elevation:

Topography:
__ Hill
__ Slope
X Upland
__ Valley

19. Remarks:
Owner To ~~Install~~ Concret Slab around Well

20. Water well contractor's certification:
This well was drilled under my jurisdiction and this report is true to the best of my knowledge and belief. 2574
Winterwell Drilling License No.
Business name
Address R2 Box 30 Augusta
Signed Charles Winter Date 3/28/79
Authorized representative

Forward the white, blue and pink copies to the Department of Health and Environment

Form WWC-5

M1-1023

31 T 9 R 7 E W 31 Sec SE 1/4 NW 1/4