


1 LOCATION OF WATER WELL:	Fraction	Section Number	Township Number	Range Number
County: Butler	NW 1/4 NW 1/4 SW 1/4	32	T 27 S	R 4 E/W

Distance and direction from nearest town or city street address of well if located within city?

From Augusta: 2 1/2 W. 1 1/2 S.

2 WATER WELL OWNER:	Board of Agriculture, Division of Water Resources
RR#, St. Address, Box # :	Application Number:
City, State, ZIP Code :	

3 LOCATE WELL'S LOCATION WITH AN "X" IN SECTION BOX:	4 DEPTH OF COMPLETED WELL: 100 ft. ELEVATION:
--	---

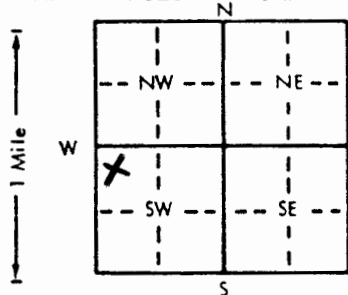

Depth(s) Groundwater Encountered 1. 69 ft. 2. 85 ft. 3. . ft.
WELL'S STATIC WATER LEVEL 32 ft. below land surface measured on mo/day/yr
Pump test data: Well water was . ft. after . hours pumping . gpm
Est. Yield 70 gpm: Well water was . ft. after . hours pumping . gpm
Bore Hole Diameter 10 in. to . ft., and . in. to . ft.
WELL WATER TO BE USED AS:
1 Domestic 3 Feedlot 6 Oil field water supply 9 Dewatering 12 Other (Specify below)
2 Irrigation 4 Industrial 7 Lawn and garden only 10 Observation well
Was a chemical/bacteriological sample submitted to Department? Yes. No. If yes, mo/day/yr sample was submitted
Water Well Disinfected? Yes No

5 TYPE OF BLANK CASING USED:	5 Wrought iron	8 Concrete tile	CASING JOINTS: Glued Clamped
1 Steel	3 RMP (SR)	6 Asbestos-Cement	9 Other (specify below)
2 PVC	4 ABS	7 Fiberglass	10 Asbestos-cement
Blank casing diameter 5 in. to 12 in. weight 20 lbs./ft. Wall thickness or gauge No.			

TYPE OF SCREEN OR PERFORATION MATERIAL:	7 PVC	10 Asbestos-cement
1 Steel	3 Stainless steel	5 Fiberglass
2 Brass	4 Galvanized steel	6 Concrete tile
SCREEN OR PERFORATION OPENINGS ARE:	5 Gauzed wrapped	8 Saw cut
1 Continuous slot	3 Mill slot	6 Wire wrapped
2 Louvered shutter	4 Key punched	7 Torch cut
SCREEN-PERFORATED INTERVALS:	From 100 ft. to 80 ft.	From 80 ft. to 15 ft.
GRAVEL PACK INTERVALS:	From 100 ft. to 15 ft.	From 15 ft. to 0 ft.

6 GROUT MATERIAL:	1 Neat cement	2 Cement grout	3 Bentonite	4 Other
Grout Intervals:	From 15 ft. to 3 ft.	From 3 ft. to 0 ft.	From 0 ft. to 0 ft.	From 0 ft. to 0 ft.

What is the nearest source of possible contamination:	10 Livestock pens	14 Abandoned water well
1 Septic tank	4 Lateral lines	7 Pit privy
2 Sewer lines	5 Cess pool	8 Sewage lagoon
3 Watertight sewer lines	6 Seepage pit	9 Feedyard
Direction from well? South	How many feet? +100	

FROM	TO	LITHOLOGIC LOG	FROM	TO	LITHOLOGIC LOG
100	85	Dark Gray Shale			
85	80	Red Bed			
80	73	Light Gray Shale			
73	69	Dark Gray Shale			
69	9	Brown Clay			
9	7	Bricky Brown Sand			
7	0	Earth			

7 CONTRACTOR'S OR LANDOWNER'S CERTIFICATION:	This water well was (1) constructed, (2) reconstructed, or (3) plugged under my jurisdiction and was completed on (mo/day/year) May 28, 1982	and this record is true to the best of my knowledge and belief. Kansas Water Well Contractor's License No. 424	This Water Well Record was completed on (mo/day/yr) June 3, 1982
--	--	--	--

under the business name of	Reiser well Drilling	by (signature) Jerry Reiser
----------------------------	----------------------	-----------------------------

INSTRUCTIONS: Use typewriter or ball point pen, PLEASE PRESS FIRMLY and PRINT clearly. Please fill in blanks, underline or circle the correct answers. Send top three copies to Kansas Department of Health and Environment, Division of Environment, Environmental Geology Section, Topeka, KS 66620. Send one to WATER WELL OWNER and retain one for your records.
--

OFFICE USE ONLY

1

1

E/W

S.E.C.

1/4

1/4

1/4