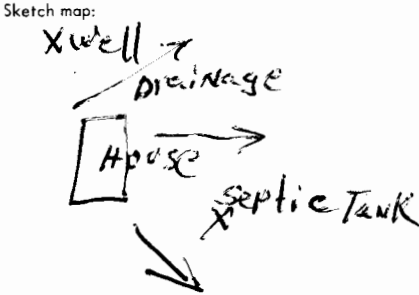
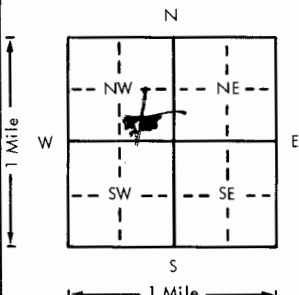


USE TYPEWRITER OR BALL
POINT PEN-PRESS FIRMLY,
PRINT CLEARLY.

WATER WELL RECORD
KSA 82a-1201-1215

Kansas Department of Health and
Environment-Division of Environment
(Water well Contractors)
Topeka, Kansas 66620

1. Location of well:		County Butler	Fraction SW 1/4 SE 1/4 NW 1/4	Section number 33	Township number T 27 S	Range number R 4 E
2. Distance and direction from nearest town or city: 1 1/2 miles south of Augusta		3. Owner of well: Alan McClure R.R. or street: RT #3 City, state, zip code: Augusta KS.				
4. Locate with "X" in section below:		Sketch map: 			6. Bore hole dia. 8.5 in. Completion date 9-11-79 Well depth 66 ft.	
		7. ☒ Cable tool ☐ Rotary ☐ Driven ☐ Dug ☐ Hollow rod ☐ Jetted ☐ Bored ☐ Reverse rotary				
		8. Use: ☒ Domestic ☐ Public supply ☐ Industry ☐ Irrigation ☐ Air conditioning ☐ Stock ☐ Lawn ☐ Oil field water ☐ Other				
5. Type and color of material					9. Casing: Material PLTS Height: Above or below Threaded ☐ Welded GLC Surface 12 in. RMP ☒ PVC ☐ Weight ☐ lbs./ft. Dia. 5 in. to 66 ft. depth Wall Thickness: inches or Dia. ☐ in. to ☐ ft. depth gage No. 200	
		From	To		10. Screen: Manufacturer's name SUNFLOWER NA Type RMP Dia. 5' Slot/gauze 3/64 Length 10 Set between 56 ft. and 66 ft. ft. and ☐ ft. Gravel pack? NO Size range of material ☐	
Fall dirt		0	2		11. Static water level: ☐ mo./day/yr. 12 ft. below land surface Date 4-11-79	
Clay Red		2	26		12. Pumping level below land surfaces: NA ft. after ☐ hrs. pumping ☐ g.p.m. ft. after ☐ hrs. pumping ☐ g.p.m. Estimated maximum yield ☐ g.p.m.	
Gravel Light yellow		26	38		13. Water sample submitted: ☐ mo./day/yr. ☐ Yes ☒ No Date ☐	
Shale blue gray		38	66		14. Well head completion: ☒ Pitless adapter ☐ Inches above grade	
(water at 55')					15. Well grouted? yes With: ☐ Neat cement ☐ Bentonite ☒ Concrete Depth: From 38 ft. to 4 ft.	
					16. Nearest source of possible contamination: ft. 150 Direction SE Type septic Well disinfected upon completion? ☒ Yes ☐ No	
					17. Pump: ☐ Not installed Manufacturer's name ☐ Model number ☐ HP ☐ Volts ☐ Length of drop pipe ☐ ft. capacity ☐ g.p.m. Type: ☐ Submersible ☐ Turbine ☐ Jet ☐ Reciprocating ☐ Centrifugal ☐ Other	
					20. Water well contractor's certification: This well was drilled under my jurisdiction and this report is true to the best of my knowledge and belief. Brady Water Wells 363 Business name Rt 2 Douglas KS. License No. ☐ Address Richard Brady Date 9-11-79 Signed ☐ Authorized representative	
18. Elevation:		19. Remarks: owner will install concrete slab				
Topography: ☒ Hill ☒ Slope ☐ Upland ☐ Valley						

Forward the white, blue and pink copies to the Department of Health and Environment

Form WWC-5