

1 LOCATION OF WATER WELL:

County: Butler

Fraction: NE $\frac{1}{4}$ NW $\frac{1}{4}$ NE $\frac{1}{4}$

Section Number: 14

Township Number: T 27 S

Range Number: R 4 E/W

Distance and direction from nearest town or city street address of well if located within city?

IN CITY OF Augusta

2 WATER WELL OWNER:

Rich Poage

RR#, St. Address, Box #

City, State, ZIP Code


Mo 8 Taylor Augusta Kan

67010

Board of Agriculture, Division of Water Resources

Application Number:

3 LOCATE WELL'S LOCATION WITH AN "X" IN SECTION BOX:

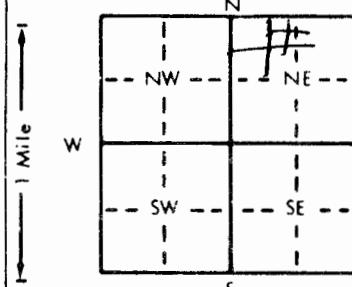

4 DEPTH OF COMPLETED WELL:

Depth(s) Groundwater Encountered 125 ft. ELEVATION: ft.

WELL'S STATIC WATER LEVEL 30 ft. below land surface measured on mo/day/yr

Pump test data: Well water was ft. after hours pumping gpm

Est. Yield 30 gpm Well water was ft. after hours pumping gpm

Bore Hole Diameter 32 in. to ft. and in. to ft.

WELL WATER TO BE USED AS: 5 Public water supply 8 Air conditioning 11 Injection well

1 Domestic 3 Feedlot 6 Oil field water supply 9 Dewatering 12 Other (Specify below)

2 Irrigation 4 Industrial 7 Lawn and garden only 10 Monitoring well

Was a chemical/bacteriological sample submitted to Department? Yes No X If yes, mo/day/yr sample was submitted Water Well Disinfected? Yes X No

5 TYPE OF BLANK CASING USED:

1 Steel 3 RMP (SR)
2 PVC 4 ABS

5 Wrought iron

8 Concrete tile

CASING JOINTS: Glued X Clamped

6 Asbestos-Cement

9 Other (specify below)

Welded

7 Fiberglass

Threaded

Blank casing diameter 5 in. to 40 ft.

Casing height above land surface 18 in., weight 160 lbs./ft. Wall thickness or gauge No. 214

TYPE OF SCREEN OR PERFORATION MATERIAL:

1 Steel 3 Stainless steel
2 Brass 4 Galvanized steel

5 Fiberglass

8 RMP (SR)

11 None (open hole)

6 Concrete tile

9 ABS

10 Asbestos-cement

SCREEN OR PERFORATION OPENINGS ARE:

5 Gauzed wrapped

8 Saw cut

11 None (open hole)

6 Wire wrapped

9 Drilled holes

7 Torch cut

10 Other (specify)

SCREEN-PERFORATED INTERVALS: From 40 ft. to 125 ft. From ft. to ft. From ft. to ft.

GRAVEL PACK INTERVALS: From ft. to ft. From ft. to ft. From ft. to ft.

From ft. to ft. From ft. to ft. From ft. to ft.

6 GROUT MATERIAL:

Grout Intervals: From 3 ft. to 23 ft.

2 Cement grout

3 Bentonite

4 Other

From ft. to ft., From ft. to ft., From ft. to ft.

What is the nearest source of possible contamination:

1 Septic tank 4 Lateral lines

7 Pit privy

10 Livestock pens

14 Abandoned water well

2 Sewer lines 5 Cess pool

8 Sewage lagoon

11 Fuel storage

15 Oil well/Gas well

X Watertight sewer lines 6 Seepage pit

9 Feedyard

12 Fertilizer storage

16 Other (specify below)

13 Insecticide storage

Direction from well?

LITHOLOGIC LOG

TO

PLUGGING INTERVALS

FROM TO

0 3 Soil

3 15 Clay

15 20 Rock

20 125 Shale/Lime

7 CONTRACTOR'S OR LANDOWNER'S CERTIFICATION: This water well was X constructed, (2) reconstructed, or (3) plugged under my jurisdiction and was completed on (mo/day/year) 7/29/94 and this record is true to the best of my knowledge and belief. Kansas

Water Well Contractor's License No. 251 This Water Well Record was completed on (mo/day/year) 7/26/94 under the business name of Winter Well Drill by (signature) Challa Winter