

1 LOCATION OF WATER WELL:

Fraction

NW  $\frac{1}{4}$  SE  $\frac{1}{4}$  NW  $\frac{1}{4}$ 

Section Number

Township Number

Range Number

County: Butler

T 27 S

R 40 E

Distance and direction from nearest town or city street address of well if located within city?

IN CITY

2 WATER WELL OWNER:

Bob Steven

Augusta Kan

RR#, St. Address, Box #

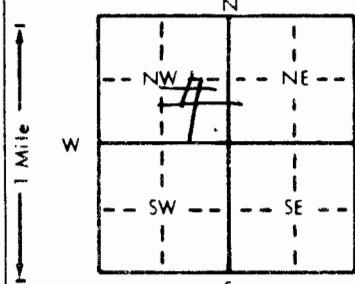
No 12 Ranchwood

67010

Board of Agriculture, Division of Water Resources

City, State, ZIP Code

Application Number:

3 LOCATE WELL'S LOCATION WITH  
AN "X" IN SECTION BOX:

4 DEPTH OF COMPLETED WELL: 125 ft. ELEVATION: .....

Depth(s) Groundwater Encountered 1. 85 ft. 2. .... ft. 3. .... ft.

WELL'S STATIC WATER LEVEL: 30 ft. below land surface measured on mo/day/yr

Pump test data: Well water was ..... ft. after ..... hours pumping ..... gpm

Est. Yield 30 gpm: Well water was ..... ft. after ..... hours pumping ..... gpm

Bore Hole Diameter 9.5 in. to ..... ft. and ..... in. to ..... ft.

WELL WATER TO BE USED AS: 5 Public water supply 8 Air conditioning 11 Injection well

1 Domestic 3 Feedlot 6 Oil field water supply 9 Dewatering 12 Other (Specify below)

2 Irrigation 4 Industrial 7 Lawn and garden only 10 Monitoring well

Was a chemical/bacteriological sample submitted to Department? Yes ..... No X; If yes, mo/day/yr sample was submitted

Water Well Disinfected? Yes X No

5 TYPE OF BLANK CASING USED:

1 Steel

3 RMP (SR)

2 PVC

4 ABS

5 Wrought iron

8 Concrete tile

CASING JOINTS: Glued X Clamped .....

6 Asbestos-Cement

9 Other (specify below)

Welded .....

7 Fiberglass

Threaded .....

Blank casing diameter ..... in. to ..... ft.

50

Casing height above land surface. 18 in., weight

160

lbs./ft. Wall thickness or gauge No. 12.14

TYPE OF SCREEN OR PERFORATION MATERIAL:

1 Steel

3 Stainless steel

5 Fiberglass

8 RMP (SR)

10 Asbestos-cement

2 Brass

4 Galvanized steel

6 Concrete tile

9 ABS

11 Other (specify) .....

18 None used (open hole)

SCREEN OR PERFORATION OPENINGS ARE:

1 Continuous slot

3 Mill slot

5 Gauzed wrapped

2 Louvered shutter

4 Key punched

6 Wire wrapped

7 Torch cut

10 Other (specify) .....

SCREEN-PERFORATED INTERVALS: From. 50 ft. to 125 ft. From. .... ft. to .... ft.

From. .... ft. to .... ft.

From. .... ft. to .... ft.

From. .... ft. to .... ft.

From. .... ft. to .... ft.

GRAVEL PACK INTERVALS: From. .... ft. to .... ft. From. .... ft. to .... ft.

From. .... ft. to .... ft. From. .... ft. to .... ft.

From. .... ft. to .... ft. From. .... ft. to .... ft.

6 GROUT MATERIAL: 1 Neat cement 2 Cement grout 3 Bentonite 4 Other

Grout Intervals: From. 0 ft. to 23 ft. From. .... ft. to .... ft. From. .... ft. to .... ft.

10 Livestock pens

14 Abandoned water well

What is the nearest source of possible contamination:

11 Fuel storage

15 Oil well/Gas well

1 Septic tank

4 Lateral lines

7 Pit privy

12 Fertilizer storage

2 Sewer lines

5 Cess pool

8 Sewage lagoon

13 Insecticide storage

3 Watertight sewer lines

6 Seepage pit

9 Feedyard

14 Other (specify) .....

Direction from well?

How many feet? 175

5

10

927

928

