

WATER WELL RECORD

Form WWC-5

KSA 82a-1212

1 LOCATION OF WATER WELL:

County: Butler

Fraction

008

SE $\frac{1}{4}$ SW $\frac{1}{4}$ SW $\frac{1}{4}$

Section Number

22

Township Number

T 27

S

Range Number

R 4

EW

Distance and direction from nearest town or city street address of well if located within city?

In town

2 WATER WELL OWNER:

Coastal Mart

610 W. 7th


Board of Agriculture, Division of Water Resources

RR#, St. Address, Box #

Augusta, Ks.

Application Number:

3 LOCATE WELL'S LOCATION WITH AN "X" IN SECTION BOX:

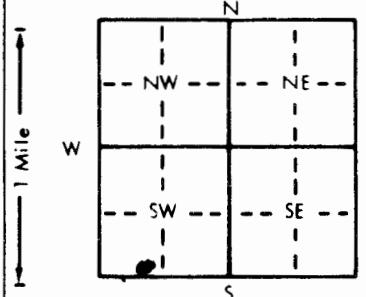

4 DEPTH OF COMPLETED WELL

14'

ft. ELEVATION:

Depth(s) Groundwater Encountered 1. None ft. 2. ft. 3. ft.

WELL'S STATIC WATER LEVEL ft. below land surface measured on mo/day/yr

Pump test data: Well water was ft. after hours pumping gpm

Est. Yield gpm: Well water was ft. after hours pumping gpm

Bore Hole Diameter in. to ft. and in. to ft.

WELL WATER TO BE USED AS: 5 Public water supply 8 Air conditioning 11 Injection well

1 Domestic 3 Feedlot 6 Oil field water supply 9 Dewatering

2 Irrigation 4 Industrial 7 Lawn and garden only 10 Monitoring well

Was a chemical/bacteriological sample submitted to Department? Yes No. If yes, mo/day/yr sample was submitted

Water Well Disinfected? Yes No

5 TYPE OF BLANK CASING USED:

1 Steel 3 RMP (SR)
2 PVC 4 ABS

5 Wrought iron 8 Concrete tile CASING JOINTS: Glued Clamped

6 Asbestos-Cement 9 Other (specify below) Welded X

7 Fiberglass Threaded

Blank casing diameter in. to in. ft., Dia in. to ft., Dia in. SDR 13 ft.

Casing height above land surface Flush Mount in. weight lbs./ft. Wall thickness or gauge No. SCh 40 ft.

TYPE OF SCREEN OR PERFORATION MATERIAL:

1 Steel 3 Stainless steel
2 Brass 4 Galvanized steel5 Fiberglass 8 RMP (SR)
6 Concrete tile 9 ABS

10 Asbestos-cement

11 Other (specify)

12 None used (open hole)

SCREEN OR PERFORATION OPENINGS ARE:

1 Continuous slot 3 Mill slot
2 Louvered shutter 4 Key punched

5 Gauzed wrapped

8 Saw cut

11 None (open hole)

6 Wire wrapped

9 Drilled holes

7 Torch cut

10 Other (specify)

SCREEN-PERFORATED INTERVALS: From 13'5" ft. to 8'5" ft., From ft. to ft. ft. to ft.

From ft. to ft., From ft. to ft. ft. to ft.

GRAVEL PACK INTERVALS: From 14'0" ft. to 4' ft., From ft. to ft. ft. to ft.

From ft. to ft., From ft. to ft. ft. to ft.

6 GROUT MATERIAL:

1 Neat cement
2 Cement grout
3 Bentonite

4 Other

Grout Intervals: From 4' ft. to 2' ft., From 2' ft. to 0' ft., From 0' ft. to ft. ft.

10 Livestock pens

14 Abandoned water well

What is the nearest source of possible contamination:

15 Oil well/Gas well

1 Septic tank 4 Lateral lines
2 Sewer lines 5 Cess pool
3 Watertight sewer lines 6 Seepage pit

16 Other (specify below)

7 Pit privy
8 Sewage lagoon
9 Feedyard11 Fuel storage
12 Fertilizer storage
13 Insecticide storage

How many feet? 5'

Direction from well? South

		LITHOLOGIC LOG		FROM	TO	PLUGGING INTERVALS	
0	.50	Asphalt					
.50	2	Dk brn-gray silty gravelly clay, moist, odor, ls.rx chert gravel fill.					
2	5.50	Dk gray silty clay, moist, odor, few ls.rx. chert frag.fill.					
5.50	11.75	Olive silty clay, stiff, moist, odor, few ls.rx.gravel to coarse grained frag.					
11.75	14'	Gray brn to brn sandy silt to silty sand, moist to wet, mod odor.					

7 CONTRACTOR'S OR LANDOWNER'S CERTIFICATION:

This water well was (1) constructed, (2) reconstructed, or (3) plugged under my jurisdiction and was completed on (mo/day/year) 12-29-94 and this record is true to the best of my knowledge and belief. KansasWater Well Contractor's License No. JB Environmental Drilling This Water Well Record was completed on (mo/day/yr) 1-2-95 by (signature) James Becker