

1 LOCATION OF WATER WELL:

County: Butler

Fraction

NE $\frac{1}{4}$ NW $\frac{1}{4}$ NE $\frac{1}{4}$

Section Number

27

Township Number

T 27 S

Distance and direction from nearest town or city street address of well if located within city?

635 State St Augusta KS

2 WATER WELL OWNER:

Town + Country Markets


RR#, St. Address, Box # : P.O. Box 17087

Board of Agriculture, Division of Water Resources

City, State, ZIP Code : Wichita, KS 67217

Application Number:

3 LOCATE WELL'S LOCATION WITH AN "X" IN SECTION BOX:

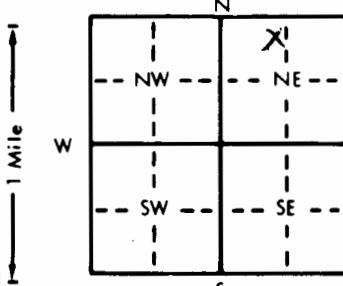

4 DEPTH OF COMPLETED WELL .18 ft. ELEVATION:

Depth(s) Groundwater Encountered 1. 6.5 ft. 2. ft. 3. ft.

WELL'S STATIC WATER LEVEL ft. below land surface measured on mo/day/yr

Pump test data: Well water was ft. after hours pumping gpm

Est. Yield gpm: Well water was ft. after hours pumping gpm

Bore Hole Diameter 7.14 in. to 18 ft. and in. to ft.

WELL WATER TO BE USED AS: 5 Public water supply 8 Air conditioning 11 Injection well

1 Domestic 3 Feedlot 6 Oil field water supply 9 Dewatering 12 Other (Specify below)

2 Irrigation 4 Industrial 7 Lawn and garden only 10 Monitoring well

Was a chemical/bacteriological sample submitted to Department? Yes No If yes, mo/day/yr sample was submitted

Water Well Disinfected? Yes No

5 TYPE OF BLANK CASING USED:

1 Steel 3 RMP (SR)
2 PVC 4 ABS

5 Wrought iron

8 Concrete tile

CASING JOINTS: Glued Clamped

6 Asbestos-Cement
7 Fiberglass

9 Other (specify below)

Welded

Threaded X

Blank casing diameter 2 in. to 3 ft. Dia in. to ft. Dia in. to in. to ft.

Casing height above land surface 8 in. weight Sch 40 lbs./ft. Wall thickness or gauge No.

TYPE OF SCREEN OR PERFORATION MATERIAL:

1 Steel 3 Stainless steel
2 Brass 4 Galvanized steel

5 Fiberglass

8 RMP (SR)

10 Asbestos-cement

6 Concrete tile

9 ABS

11 Other (specify)

12 None used (open hole)

SCREEN OR PERFORATION OPENINGS ARE:

1 Continuous slot 3 Mill slot
2 Louvered shutter 4 Key punched

5 Gauzed wrapped

8 Saw cut

11 None (open hole)

6 Wire wrapped

9 Drilled holes

7 Torch cut

10 Other (specify)

SCREEN-PERFORATED INTERVALS: From .18 ft. to 3 ft. From ft. to ft. From ft. to ft.

From ft. to ft. From ft. to ft. From ft. to ft.

GRAVEL PACK INTERVALS: From .18 ft. to 2.5 ft. From ft. to ft. From ft. to ft.

From ft. to ft. From ft. to ft. From ft. to ft.

6 GROUT MATERIAL: 1 Neat cement 2 Cement grout 3 Bentonite 4 Other

Grout Intervals: From 2 ft. to 0.3 ft. From 2.5 ft. to 2 ft. From ft. to ft.

What is the nearest source of possible contamination:

1 Septic tank 4 Lateral lines
2 Sewer lines 5 Cess pool
3 Watertight sewer lines 6 Seepage pit

7 Pit privy

8 Sewage lagoon

9 Feedyard

10 Livestock pens

11 Fuel storage

12 Fertilizer storage

13 Insecticide storage

14 Abandoned water well

15 Oil well/Gas well

16 Other (specify below)

Direction from well? North

How many feet? 60

FROM TO LITHOLOGIC LOG FROM TO PLUGGING INTERVALS

0	4	Top soil	FROM	TO	PLUGGING INTERVALS
4	10	13 in. Silty clay moist at 7.0			
10	15	13 in. Tan S. clay			
15	18	Tan S. clay Wet at 17.0			

7 CONTRACTOR'S OR LANDOWNER'S CERTIFICATION: This water well was (1) constructed, (2) reconstructed, or (3) plugged under my jurisdiction and was

completed on (mo/day/year) 6-16-95 and this record is true to the best of my knowledge and belief. Kansas

Water Well Contractor's License No. 575 This Water Well Record was completed on (mo/day/yr) 6-23-95

under the business name of Kurtz Environmental Services by (signature)