

Range Number

E/W

1 LOCATION OF WATER WELL:

Fraction

Section Number

Township Number

County: Butler

NE 1/4 NW 1/4 NE 1/4

27

T 27 S

R 4

Distance and direction from nearest town or city street address of well if located within city?

635 State St, Augusta, KS

2 WATER WELL OWNER:

Town & Country Markets

RR#, St. Address, Box #:

P.O. Box 17087


Board of Agriculture, Division of Water Resources

City, State, ZIP Code:

Wichita, Kansas 67217

Application Number:

3 LOCATE WELL'S LOCATION WITH AN "X" IN SECTION BOX:

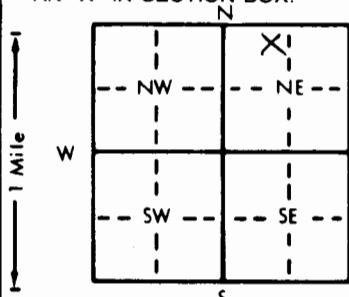

4 DEPTH OF COMPLETED WELL... 16.0 ft. ELEVATION:

Depth(s) Groundwater Encountered 1. 6.5 ft. 2. ft. 3. ft.

WELL'S STATIC WATER LEVEL ft. below land surface measured on mo/day/yr

Pump test data: Well water was ft. after hours pumping gpm

Est. Yield gpm: Well water was ft. after hours pumping gpm

Bore Hole Diameter 7 1/4 in. to 16 ft. and in. to ft.

WELL WATER TO BE USED AS: 5 Public water supply 8 Air conditioning 11 Injection well

1 Domestic 3 Feedlot 6 Oil field water supply 9 Dewatering 12 Other (Specify below)

2 Irrigation 4 Industrial 7 Lawn and garden only 10 Monitoring well

Was a chemical/bacteriological sample submitted to Department? Yes.....No..... If yes, mo/day/yr sample was submitted

Water Well Disinfected? Yes No

5 TYPE OF BLANK CASING USED:

1 Steel 3 RMP (SR)
 PVC 4 ABS

5 Wrought iron 8 Concrete tile

CASING JOINTS: Glued Clamped

6 Asbestos-Cement 9 Other (specify below)

Welded

7 Fiberglass

Threaded

Blank casing diameter 2 1/2 in. to 3 ft., Dia. in. to ft., Dia. in. to ft.

Casing height above land surface 0 in., weight Sched 40 lbs./ft. Wall thickness or gauge No.

TYPE OF SCREEN OR PERFORATION MATERIAL:

1 Steel 3 Stainless steel
2 Brass 4 Galvanized steel5 Fiberglass 8 RMP (SR)
6 Concrete tile 9 ABS PVC 10 Asbestos-cement

11 Other (specify)

12 None used (open hole)

SCREEN OR PERFORATION OPENINGS ARE:

1 Continuous slot Mill slot
2 Louvered shutter 4 Key punched

5 Gauzed wrapped

8 Saw cut

11 None (open hole)

6 Wire wrapped

9 Drilled holes

7 Torch cut

10 Other (specify)

SCREEN-PERFORATED INTERVALS: From 16 ft. to 24 ft., From ft. to ft.

From ft. to ft., From ft. to ft.

GRAVEL PACK INTERVALS: From 16 ft. to 3 ft., From ft. to ft., From ft. to ft.

From ft. to ft., From ft. to ft.

6 GROUT MATERIAL: 1 Neat cement Cement grout Bentonite 4 Other

Grout Intervals: From 2.5 ft. to 0.3 ft., From 3 ft. to 2.5 ft., From ft. to ft.

What is the nearest source of possible contamination:

1 Septic tank 4 Lateral lines
2 Sewer lines 5 Cess pool

7 Pit privy

 Watertight sewer lines 6 Seepage pit

8 Sewage lagoon

9 Feedyard

10 Livestock pens

14 Abandoned water well

11 Fuel storage

15 Oil well/Gas well

12 Fertilizer storage

16 Other (specify below)

13 Insecticide storage

How many feet? 10'

Direction from well? South

7 CONTRACTOR'S OR LANDOWNER'S CERTIFICATION: This water well was constructed, reconstructed, or plugged under my jurisdiction and was completed on (mo/day/year) 6-19-95 and this record is true to the best of my knowledge and belief. Kansas

Water Well Contractor's License No. 575 This Water Well Record was completed on (mo/day/yr) 11-16-23-95

under the business name of Kurtz Environmental Service by (signature)