

Range Number  
R 4 EW

## 1 LOCATION OF WATER WELL:

Fraction

SE  $\frac{1}{4}$  SW  $\frac{1}{4}$  SE  $\frac{1}{4}$ 

Section Number

22

Township Number

T 27

S

Range Number

R 4 EW

County: Butler  
Distance and direction from nearest town or city street address of well if located within city?

700 State St Augusta, Ks

## 2 WATER WELL OWNER:

J + J Auto Glass

RR#, St. Address, Box #

700 state street

Board of Agriculture, Division of Water Resources

City, State, ZIP Code


Augusta, Ks. 67110

Application Number:

## 3 LOCATE WELL'S LOCATION WITH AN "X" IN SECTION BOX:

N

E

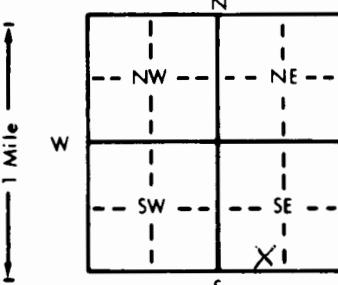

## 4 DEPTH OF COMPLETED WELL . . . 18.0 ft. ELEVATION: . . . . .

Depth(s) Groundwater Encountered 1 . . . . . ft. 2 . . . . . ft. 3 . . . . . ft.

WELL'S STATIC WATER LEVEL . . . . . ft. below land surface measured on mo/day/yr . . . . .

Pump test data: Well water was . . . . . ft. after . . . . . hours pumping . . . . . gpm

Est. Yield . . . . . gpm: Well water was . . . . . ft. after . . . . . hours pumping . . . . . gpm

Bore Hole Diameter . . . . . 7 1/4 in. to . . . . . 18.0 ft., and . . . . . in. to . . . . . ft.

WELL WATER TO BE USED AS: 5 Public water supply 8 Air conditioning 11 Injection well

1 Domestic 3 Feedlot 6 Oil field water supply 9 Dewatering 12 Other (Specify below)

2 Irrigation 4 Industrial 7 Lawn and garden only X Monitoring well

Was a chemical/bacteriological sample submitted to Department? Yes . . . . . No . . . . . If yes, mo/day/yr sample was submitted

Water Well Disinfected? Yes . . . . . No

## 5 TYPE OF BLANK CASING USED:

1 Steel 3 RMP (SR)

C PVC 4 ABS

5 Wrought iron

6 Asbestos-Cement

7 Fiberglass

8 Concrete tile

9 Other (specify below)

CASING JOINTS: Glued . . . . . Clamped . . . . .

Welded . . . . .

Threaded X

Blank casing diameter . . . . . 2 1/4 in. to . . . . . 3 ft., Dia . . . . . in. to . . . . . ft., Dia . . . . . in. to . . . . . ft.

Casing height above land surface . . . . . C in. weight . . . . . Sch. 40 lbs./ft. Wall thickness or gauge No. . . . .

## TYPE OF SCREEN OR PERFORATION MATERIAL:

1 Steel 3 Stainless steel

2 Brass 4 Galvanized steel

5 Fiberglass

6 Concrete tile

8 RMP (SR)

9 ABS

10 Asbestos-cement

11 Other (specify) . . . . .

12 None used (open hole)

## SCREEN OR PERFORATION OPENINGS ARE:

1 Continuous slot 3 Mill slot

2 Louvered shutter 4 Key punched

5 Gauzed wrapped

6 Wire wrapped

7 Torch cut

8 Saw cut

9 Drilled holes

10 Other (specify) . . . . .

11 None (open hole)

SCREEN-PERFORATED INTERVALS: From . . . . . 18 ft. to . . . . . 3 ft., From . . . . . ft. to . . . . . ft.

From . . . . . ft. to . . . . . ft., From . . . . . ft. to . . . . . ft.

GRAVEL PACK INTERVALS: From . . . . . 18 ft. to . . . . . 2 ft., From . . . . . ft. to . . . . . ft.

From . . . . . ft. to . . . . . ft., From . . . . . ft. to . . . . . ft.

6 GROUT MATERIAL: 1 Neat cement C Cement grout 3 Bentonite 4 Other . . . . .

Grout Intervals: From . . . . . 1.5 ft. to . . . . . 0 ft., From . . . . . 2 ft. to . . . . . 1.5 ft., From . . . . . ft. to . . . . . ft.

What is the nearest source of possible contamination:

1 Septic tank 4 Lateral lines

2 Sewer lines 5 Cess pool

3 Watertight sewer lines 6 Seepage pit

7 Pit privy

8 Sewage lagoon

9 Feedyard

10 Livestock pens

11 Fuel storage

12 Fertilizer storage

13 Insecticide storage

14 Abandoned water well

15 Oil well/Gas well

16 Other (specify below)

A B a n d o n e d F u l l S t o r a g e

Direction from well? East

How many feet? 50

FROM TO LITHOLOGIC LOG FROM TO PLUGGING INTERVALS

0	6	CONCRETE		
6"	3'0	Top Soi & Fill		
3.0	10'0	Brn Sh. A Clay Some S. H		
		Saturated at 7.0		
10.	15'0	Silty Brown to Tan Clay		
15.	18'0	Tan Clay		

7 CONTRACTOR'S OR LANDOWNER'S CERTIFICATION: This water well was (1) constructed, (2) reconstructed, or (3) plugged under my jurisdiction and was completed on (mo/day/year) . . . . . and this record is true to the best of my knowledge and belief, Kansas

Water Well Contractor's License No. . . . . This Water Well Record was completed on (mo/day/yr) . . . . .

under the business name of Kurtz Environmental Services by (signature) . . . . .