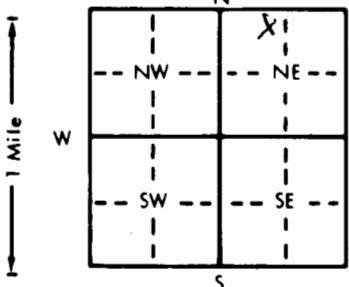


1 LOCATION OF WATER WELL:		Fraction	Section Number	Township Number	Range Number																														
County: Butler		NE $\frac{1}{4}$ NW $\frac{1}{4}$ NE $\frac{1}{4}$	27	T 27 S	R 4 E																														
Distance and direction from nearest town or city street address of well if located within city?																																			
115 East 7th St. Augusta KS																																			
2 WATER WELL OWNER: J+J Auto Glass		Board of Agriculture, Division of Water Resources																																	
RR#, St. Address, Box # : 700 STATE STREET		Application Number:																																	
City, State, ZIP Code : Augusta, Kansas 67110																																			
3 LOCATE WELL'S LOCATION WITH AN "X" IN SECTION BOX:		4 DEPTH OF COMPLETED WELL .18 ft. ELEVATION:																																	
		Depth(s) Groundwater Encountered 1. 7 ft. 2. ft. 3. ft.																																	
WELL'S STATIC WATER LEVEL ft. below land surface measured on mo/day/yr																																			
Pump test data: Well water was ft. after hours pumping gpm																																			
Est. Yield gpm: Well water was ft. after hours pumping gpm																																			
Bore Hole Diameter 7 1/4 in. to 18 ft. and in. to ft.																																			
WELL WATER TO BE USED AS: 5 Public water supply 8 Air conditioning 11 Injection well																																			
1 Domestic		3 Feedlot		6 Oil field water supply 9 Dewatering																															
2 Irrigation		4 Industrial		7 Lawn and garden only 10 Monitoring well																															
12 Other (Specify below)																																			
Was a chemical/bacteriological sample submitted to Department? Yes No If yes, mo/day/yr sample was submitted																																			
Water Well Disinfected? Yes No																																			
5 TYPE OF BLANK CASING USED: CASING JOINTS: Glued Clamped																																			
1 Steel		3 RMP (SR)		5 Wrought iron 8 Concrete tile																															
<input checked="" type="checkbox"/> PVC		4 ABS		6 Asbestos-Cement 9 Other (specify below)																															
Blank casing diameter in. to ft., Dia in. to ft., Dia in. to ft.																																			
Casing height above land surface in., weight lbs./ft. Wall thickness or gauge No.																																			
6 TYPE OF SCREEN OR PERFORATION MATERIAL: <input checked="" type="checkbox"/> PVC 10 Asbestos-cement																																			
1 Steel		3 Stainless steel		5 Fiberglass 8 RMP (SR)																															
2 Brass		4 Galvanized steel		6 Concrete tile 9 ABS																															
SCREEN OR PERFORATION OPENINGS ARE: 5 Gauzed wrapped 8 Saw cut 11 None (open hole)																																			
1 Continuous slot		3 Mill slot		6 Wire wrapped 9 Drilled holes																															
2 Louvered shutter		4 Key punched		7 Torch cut 10 Other (specify)																															
SCREEN-PERFORATED INTERVALS: From 18 ft. to 3 ft., From ft. to ft.																																			
From ft. to ft., From ft. to ft.																																			
GRAVEL PACK INTERVALS: From 18 ft. to 2.5 ft., From ft. to ft.																																			
From ft. to ft., From ft. to ft.																																			
6 GROUT MATERIAL: 1 Neat cement <input checked="" type="checkbox"/> Cement grout 3 Bentonite 4 Other																																			
Grout Intervals: From 2 ft. to 0.3 ft., From 2.5 ft. to 2 ft., From ft. to ft.																																			
What is the nearest source of possible contamination:																																			
1 Septic tank		4 Lateral lines		7 Pit privy																															
2 Sewer lines		5 Cess pool		8 Sewage lagoon																															
3 Watertight sewer lines		6 Seepage pit		9 Feedyard																															
Direction from well? South How many feet? 40'																																			
<table border="1"> <thead> <tr> <th>FROM</th> <th>TO</th> <th>LITHOLOGIC LOG</th> <th>FROM</th> <th>TO</th> <th>PLUGGING INTERVALS</th> </tr> </thead> <tbody> <tr> <td>0</td> <td>4</td> <td>Top Soil</td> <td></td> <td></td> <td></td> </tr> <tr> <td>4</td> <td>10</td> <td>Brn Silt clay moist at 7.0</td> <td></td> <td></td> <td></td> </tr> <tr> <td>10</td> <td>15</td> <td>Brn To Tan Silt clay</td> <td></td> <td></td> <td></td> </tr> <tr> <td>15</td> <td>18</td> <td>Tan Silt clay</td> <td></td> <td></td> <td></td> </tr>
7 CONTRACTOR'S OR LANDOWNER'S CERTIFICATION: This water well was <input checked="" type="checkbox"/> constructed, (2) reconstructed, or (3) plugged under my jurisdiction and was completed on (mo/day/year) 6-15-95 and this record is true to the best of my knowledge and belief. Kansas																																			
Water Well Contractor's License No. 575 This Water Well Record was completed on (mo/day/yr) 6-23-95																																			
under the business name of Kurtz Environmental Services by (signature) M. J. Kurtz																																			