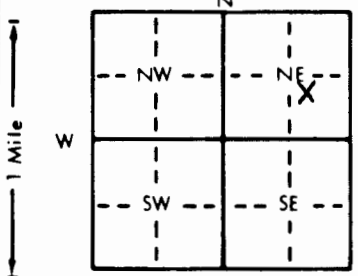


1 LOCATION OF WATER WELL: County: <u>Butler</u>	Fraction <u>NW 1/4 SE 1/4 NE 1/4</u>	Section Number <u>14</u>	Township Number <u>T 27 S</u>	Range Number <u>R 5 EW</u>
--	---	-----------------------------	----------------------------------	-------------------------------

Distance and direction from nearest town or city street address of well if located within city?

Approx 8 miles south of El Dorado (Titan missile site)

2 WATER WELL OWNER: <u>Gladys Harrison</u> RR#, St. Address, Box # : <u>2335 Wedgewood</u> City, State, ZIP Code : <u>El Dorado, KS 67042</u>	Board of Agriculture, Division of Water Resources Application Number:
---	--

3 LOCATE WELL'S LOCATION WITH AN "X" IN SECTION BOX: 	4 DEPTH OF COMPLETED WELL: <u>30</u> ft. ELEVATION: Depth(s) Groundwater Encountered 1. <u>22</u> ft. 2. ft. 3. ft. WELL'S STATIC WATER LEVEL ft. below land surface measured on mo/day/yr Pump test data: Well water was ft. after hours pumping gpm Est. Yield gpm: Well water was ft. after hours pumping gpm Bore Hole Diameter: <u>6.75</u> in. to <u>30</u> ft. and in. to ft. WELL WATER TO BE USED AS: 5 Public water supply 8 Air conditioning 11 Injection well 1 Domestic 3 Feedlot 6 Oil field water supply 9 Dewatering 12 Other (Specify below) 2 Irrigation 4 Industrial 7 Lawn and garden only <u>10 Monitoring well MW#1</u> Was a chemical/bacteriological sample submitted to Department? Yes No; If yes, mo/day/yr sample was submitted Water Well Disinfected? Yes No
--	---

5 TYPE OF BLANK CASING USED: 1 Steel <u>2 PVC</u> 3 RMP (SR) 4 ABS Blank casing diameter <u>2</u> in. to <u>16</u> ft., Dia. in. to ft., Dia. in. to ft. Casing height above land surface: <u>24</u> in., weight lbs./ft. Wall thickness or gauge No. TYPE OF SCREEN OR PERFORATION MATERIAL: 1 Steel 3 Stainless steel 5 Fiberglass 8 RMP (SR) 10 Asbestos-cement 2 Brass 4 Galvanized steel 6 Concrete tile 9 ABS 11 Other (specify) 12 None used (open hole) SCREEN OR PERFORATION OPENINGS ARE: <u>1 Continuous slot .010</u> 3 Mill slot 5 Gauzed wrapped 8 Saw cut 11 None (open hole) 2 Louvered shutter 4 Key punched 7 Torch cut 9 Drilled holes 10 Other (specify) SCREEN-PERFORATED INTERVALS: From <u>16</u> ft. to <u>24</u> ft., From ft. to ft. GRAVEL PACK INTERVALS: From <u>14</u> ft. to <u>24</u> ft., From ft. to ft. <u>10-20</u> From ft. to ft., From ft. to ft.	CASING JOINTS: Glued Clamped Welded Threaded <u>X</u>
---	---

6 GROUT MATERIAL: <u>1 Neat cement</u> 2 Cement grout <u>3 Bentonite</u> 4 Other Grout Intervals: From <u>0</u> ft. to <u>2</u> ft., From <u>2</u> ft. to <u>14</u> ft., From ft. to ft. What is the nearest source of possible contamination: 1 Septic tank 4 Lateral lines 7 Pit privy 10 Livestock pens 14 Abandoned water well 2 Sewer lines 5 Cess pool 8 Sewage lagoon 11 Fuel storage 15 Oil well/Gas well 3 Watertight sewer lines 6 Seepage pit 9 Feedyard 12 Fertilizer storage 16 Other (specify below) 13 Insecticide storage

Direction from well?

How many feet?

FROM	TO	LITHOLOGIC LOG	FROM	TO	PLUGGING INTERVALS
0	6	Brown Silt			
6	7	Wet Silt			
7	22	Gray Shale			
22	24	Wet Tan Silt			
24	30	Dark Gray Shale			

RECEIVED

OCT 15 2004

BUREAU OF WATER

7 CONTRACTOR'S OR LANDOWNER'S CERTIFICATION: This water well was <u>(1) constructed</u> (2) reconstructed, or (3) plugged under my jurisdiction and was completed on (mo/day/year) <u>09-23-04</u> and this record is true to the best of my knowledge and belief. Kansas Water Well Contractor's License No. <u>551</u> This Water Well Record was completed on (mo/day/yr) <u>10-06-04</u> under the business name of <u>Associated</u> by (signature) <u>[Signature]</u>
