USE TYPEWRITER OR BALL POINT PEN-PRESS FIRMLY, PRINT CLEARLY.

T R EW sec 1/4 1/4 1/4 No.

WATER WELL RECORD
KSA 82a-1201-1215

Kansas State Dept. Of Health
(Water Well Contractors)
Forbes-Bldg. 740
Topeka, Kansas 66620

1 Location of well:	County	Township name	Fraction	Section number	Town number	Range number
	Butler	Spring	NW 1/4	16	T27S	R5E

Distance and direction from nearest town or city: 1 mile North 3 miles East Augusta Kans

Street address of well location if in city:

3 Owner of well: Mary Schneider

Address: Route 2 Augusta Kans

Locate with "X" in section below:

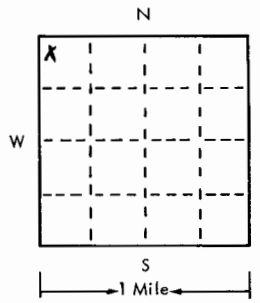

Sketch map:

4 Well depth: 60 ft. Date of completion July 12, 1975
Well diameter 7 in.

5 [X] Cable tool [ ] Rotary [ ] Driven [ ] Dug
[ ] Hollow rod [ ] Jetted [ ] Bored [ ] Reverse rotary

6 Use: [ ] Domestic [ ] Public supply [ ] Industry
[ ] Irrigation [ ] Air conditioning [ ] Commercial
[X] Test well [ ]

7 Casing: Material steel Height: (above)/below
Threaded [ ] Welded [X] Surface 12 in.
Diam. Weight 15 lbs./ft.
10 in. to 10 ft. depth Drive shoe? [ ] Yes [X] No
7 in. to 60 ft. depth

2 Type and color of material	From	To
Red Clay	0	5
yellow lime	5	35
water	35	
grey lime	35	60
Owner will put on slab		
(use a second sheet if needed)		

8 Screen: Sunflower Plastic Inc Wichita Kans
Manufacturer
Type RMP Dia. 6
Slot/gauze 16 Length 20 ft
Set between 30 ft. and ft. 50
Fittings:
Gravel pack [ ] Yes [X] No Size range of material

9 Static water level:
20 ft. below land surface Date July 12, 1975

10 Pumping level below land surfaces:
ft. after hrs. pumping g.p.m.
ft. after hrs. pumping g.p.m.
Estimated maximum yield 1 g.p.m.

11 Water sample submitted:
[ ] Yes [X] No Date

12 Well head completion:
[ ] Pitless adapter [ ] 12 Inches above grade

13 Well grouted? [X] Yes [ ] No
[X] Neat cement [ ] Bentonite [ ]
Depth: From 10 ft. to 0 ft.

14 Nearest source of possible contamination:
nothing within 1/4 mile either direction
ft. Direction Type
Well disinfected upon completion? [X] Yes [ ] No

15 Pump: [X] Not installed
Manufacturer's name
Model number HP Volts
Length of drop pipe ft. capacity g.m.p.
Type:
[ ] Submersible [ ] Turbine
[ ] Jet [ ] Reciprocating
[ ] Certrifugal [ ] Other

16 Remarks: elevation

Topography:
[X] Hill
[ ] Slope
[ ] Upland
[ ] Valley

17 Water well contractor's certification:
This well was drilled under my jurisdiction and this report is true to the best of my knowledge and belief.
Murray Wells
Business name License No.
Address Augusta Ks 122
Signed Murray Wells Date July 12 1975
Authorized representative

Forward the white, blue and pink copies to the Kansas State Dept. Of Health.

Form WWC-5