




SE-NE-30-27S-5E
 0-55'
 Chase
 Gage shale to Fort Riley Ls

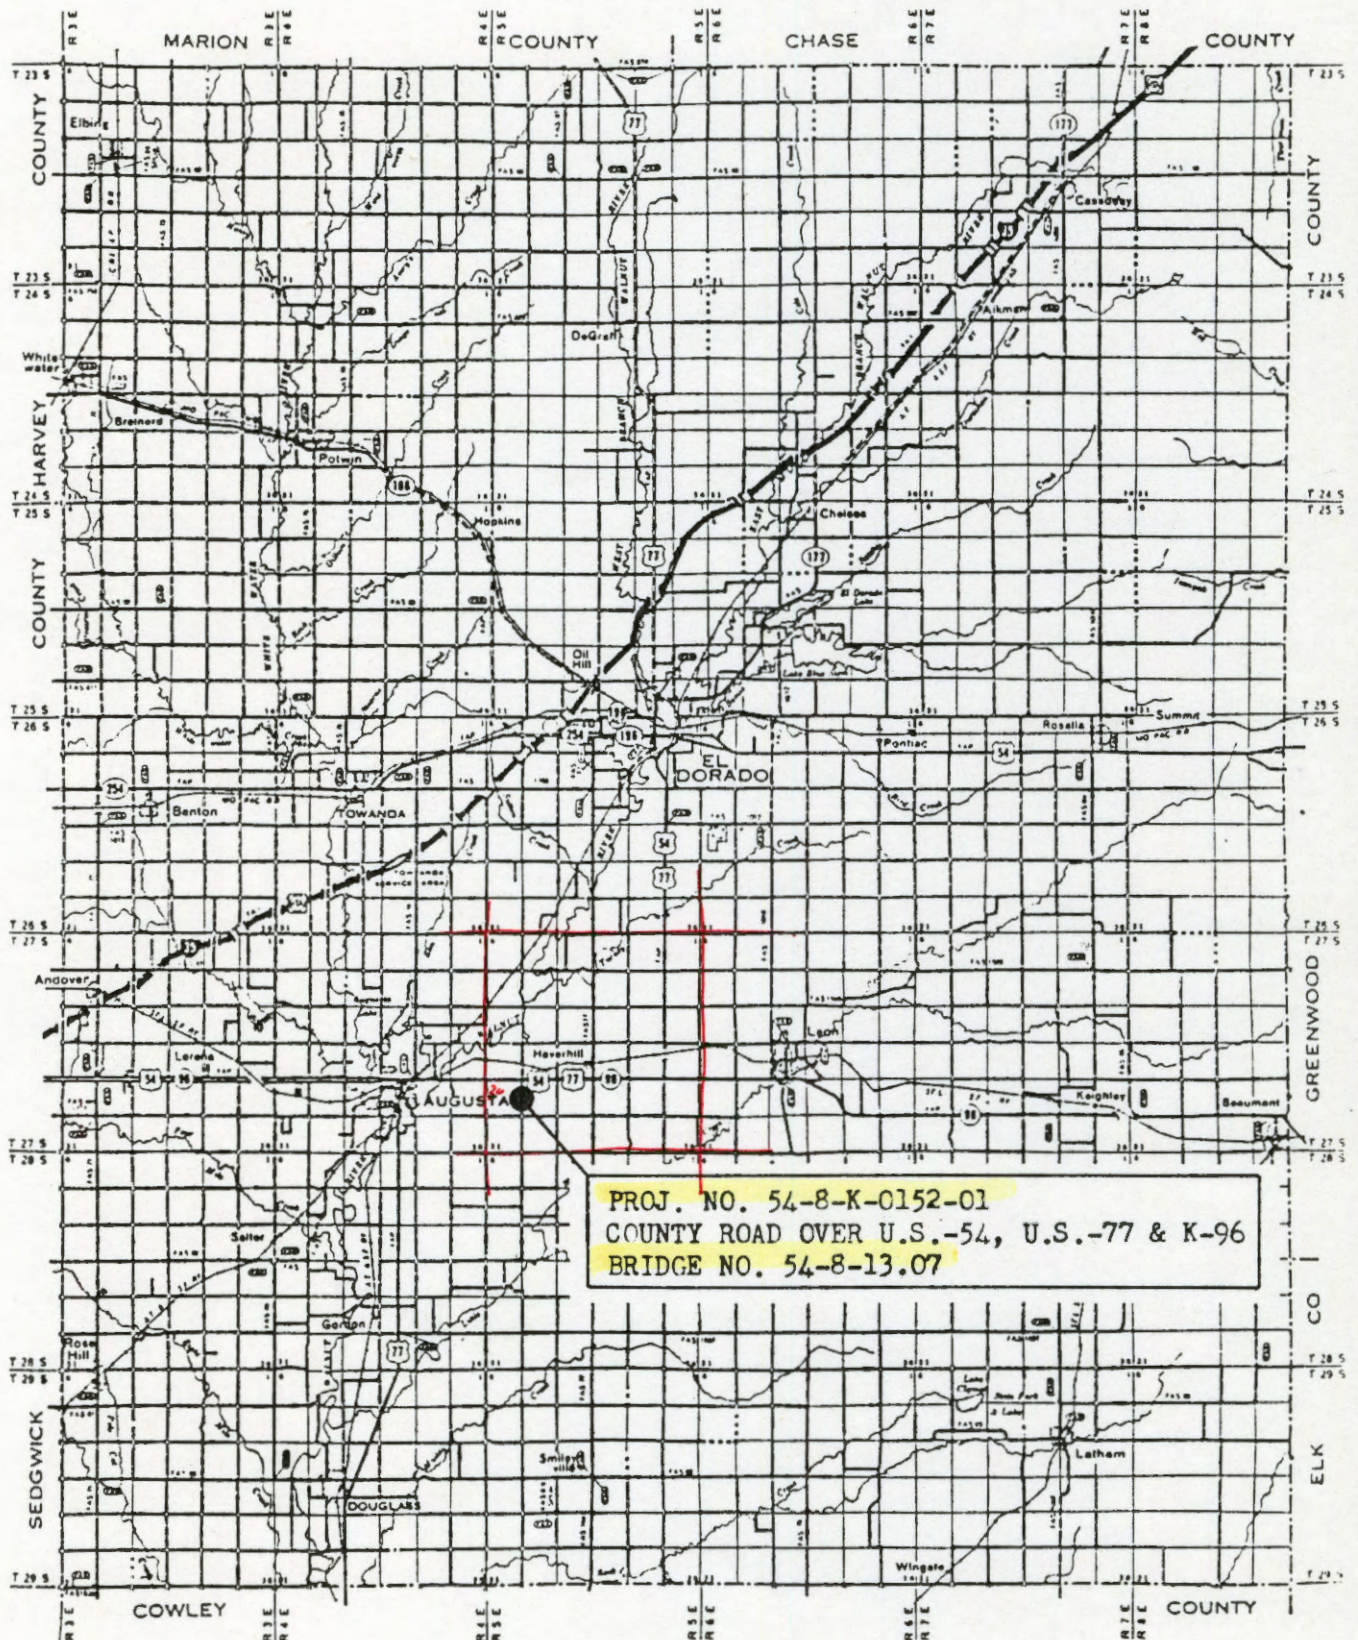

GENERAL HIGHWAY MAP
 BUTLER COUNTY
 KANSAS

APPROVED BY THE
 STATE HIGHWAY COMMISSION OF KANSAS
 DEPARTMENT OF PLANNING AND DEVELOPMENT
 U. S. DEPARTMENT OF TRANSPORTATION
 FEDERAL HIGHWAY ADMINISTRATION

1964
 1:50,000

Core Description

Proj. 54-B-K 0152-01

Br. No. 13.07 - Butler Co.

CD #2, Sta. 50+85.5, 124.

Core 1	Cut 3.8 Rec. 1.8
1.0	Shale, maroon, Silty with thin siltstone stringers
0.8	Shale, maroon with some green-gray, clayey
1.8	Total Recovery
Core 2	Cut 5.0 Rec. 3.9
3.9	Shale, maroon and green, silty and clayey with some gray-green siltstone zones and stringers.
3.9	Total Recovery
Core 3	Cut 5.0 Rec. 1.2 (poor recovery: lost much of the softer clayey portion and retained the firmer silty shale)
1.2	Shale, mostly maroon w/ minor amount of green and gray-green, silty and clayey (in zones) mostly maroon recovered.
1.2	Total Recovery

Continued drilling with "N" Hawthorne.