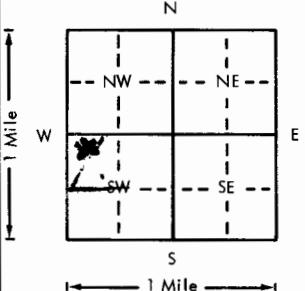
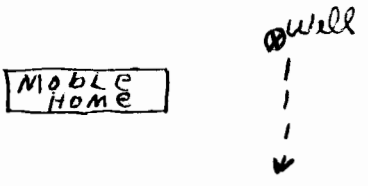


USE TYPEWRITER OR BALL
POINT PEN-PRESS FIRMLY,
PRINT CLEARLY.

WATER WELL RECORD
KSA 82a-1201-1215

Kansas Department of Health and
Environment-Division of Environment
(Water well Contractors)
Topeka, Kansas 66620

1. Location of well:		County Butler	Fraction NW 1/4 NW 1/4 SW 1/4	Section number 28	Township number T 27	Range number S R 5	Q/W
2. Distance and direction from nearest town or city: 4 E 1/2 S Street address of well location if in city: Augusta				3. Owner of well: J. R. Grier R.R. or street: Rt 2 City, state, zip code: Augusta Kans			
4. Locate with "X" in section below:		Sketch map:		6. Bore hole dia. 10 in. Completion date 7-26-77 Well depth 100 ft.			
				7. ☒ Cable tool ☐ Rotary ☐ Driven ☐ Dug ☐ Hollow rod ☐ Jetted ☐ Bored ☐ Reverse rotary			
5. Type and color of material		From		To		8. Use: ☒ Domestic ☐ Public supply ☐ Industry ☐ Irrigation ☐ Air conditioning ☐ Stock ☐ Lawn ☐ Oil field water ☐ Other	
yellow lime		0		7		9. Casing: Material plb Height: above or below Threaded ☐ Welded ☒ Surface 12 in. RMP ☒ PVC ☐ Weight 12 lbs./ft. Dia. 6 in. to 80 ft. depth Wall Thickness: inches or Dia. 6 in. to 80 ft. depth gage No. 175	
yellow shale		7		19		10. Screen: Manufacturer's name gtl Type RMP Dia. 6 Slot/gauze 1/16 Length 20 ft Set between 80 ft. and 100 ft. ft. and ft. Gravel pack? no Size range of material	
Red shale		19		44		11. Static water level: 69 ft. below land surface Date 7-26-77 mo./day/yr.	
grey lime		44		68		12. Pumping level below land surfaces: ft. after hrs. pumping g.p.m. ft. after hrs. pumping g.p.m. Estimated maximum yield 20 g.p.m.	
Blue shale		68		73		13. Water sample submitted: Yes ☒ No ☐ Date	
grey lime		73		84		14. Well head completion: Pitless adapter 12 Inches above grade	
water		84				15. Well grouted? yes With: ☒ Neat cement ☐ Bentonite ☐ Concrete Depth: From 0 ft. to 10 ft.	
grey lime		84		100		16. Nearest source of possible contamination: ft. 100 Direction West Type septic Well disinfected upon completion? ☒ Yes ☐ No	
						17. Pump: ☒ Not installed Manufacturer's name Model number HP Volts Length of drop pipe ft. capacity g.p.m. Type: ☐ Submersible ☐ Turbine ☐ Jet ☐ Reciprocating ☐ Centrifugal ☐ Other	
						20. Water well contractor's certification: This well was drilled under my jurisdiction and this report is true to the best of my knowledge and belief. Mike Well drilling 122 Business name License No. Address Rt 3 Box 57 Augusta Signed Thurman Mike Date 7-26-77 Authorized representative	
18. Elevation:		19. Remarks: owner will put on slab James R. Grier					
Topography: ☐ Hill ☐ Slope ☒ Upland ☐ Valley							

Forward the white, blue and pink copies to the Department of Health and Environment

Form WWC-5