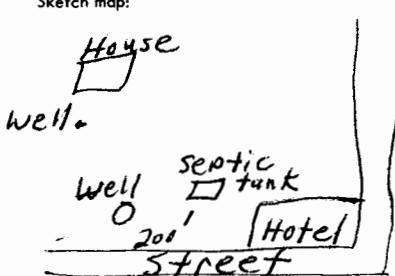


USE TYPEWRITER OR BALL
POINT PEN-PRESS FIRMLY,
PRINT CLEARLY.

WATER WELL RECORD
KSA 82a-1201-1215

Kansas Department of Health and
Environment-Division of Environment
(Water well Contractors)
Topeka, Kansas 66620

1. Location of well:	County <i>Butler</i>	Fraction <i>SW 1/4 SW 1/4 NE 1/4</i>	Section number <i>33</i>	Township number <i>T 27</i>	Range number <i>S R 8E</i>	E/W
2. Distance and direction from nearest town or city:	3. Owner of well: <i>J. C. Squire</i>					
Street address of well location if in city:	<i>In Beaumont</i>					
4. Locate with "X" in section below:	Sketch map: 					6. Bore hole dia. <i>10</i> in. Completion date <i>12-16-76</i> Well depth <i>145</i> ft.
	N					
	W					
	1 Mile					
		E				
		S				
	1 Mile					
5. Type and color of material		From	To			
<i>Top Soil</i>		<i>0'</i>	<i>3'</i>			
<i>Light brown clay</i>		<i>3'</i>	<i>12'</i>			
<i>Blue clay</i>		<i>12'</i>	<i>35'</i>			
<i>Brown Clay - some water</i>		<i>35'</i>	<i>43'</i>			
<i>Blue clay</i>		<i>43'</i>	<i>71'</i>			
<i>Greenish brown clay</i>		<i>71'</i>	<i>85'</i>			
<i>Blue Schale</i>		<i>85'</i>	<i>95'</i>			
<i>Blue soft mud</i>		<i>95'</i>	<i>100'</i>			
<i>Red clay</i>		<i>100'</i>	<i>105'</i>			
<i>Brown Schale</i>		<i>105'</i>	<i>125'</i>			
<i>Grey hard schale</i>		<i>125'</i>	<i>145'</i>			
(Use a second sheet if needed)						
18. Elevation:	19. Remarks: <i>To be completed by landowner</i>					
Topography:						
<input type="checkbox"/> Hill						
<input type="checkbox"/> Slope						
<input checked="" type="checkbox"/> Upland						
<input type="checkbox"/> Valley						
20. Water well contractor's certification: This well was drilled under my jurisdiction and this report is true to the best of my knowledge and belief. <i>EASTMAN DRILLING 299</i> Business name <i>Box 115, Winfield</i> License No. Address <i>Box 115, Winfield</i> Date <i>1-6-76</i> Signed <i>EASTMAN</i> Authorized representative						