

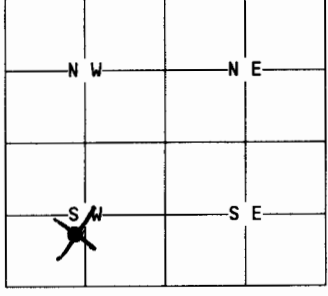
NE NE SW SW

1	LOCATION OF WATER WELL:	Fraction <u>NE</u>	Section Number	Township Number	Range Number
County: <u>Sedgwick</u>		<u>Near 1/4 Center 1/4 SE</u>	<u>31</u>	<u>28</u>	<u>1</u>

Distance and direction from nearest town or city street address of well if located within city?

EASTIn city Limits-244 Timber Lane Drive

2	WATER WELL OWNER: <u>Wilma Grise</u>
RR#, St. Address, Box #: <u>244 Timber Lane Drive</u>	
City, State, ZIP Code: <u>Haysville, KS 67060</u>	
Board of Agriculture, Division of Water Resources Application Number:	

3	MARK WELL'S LOCATION WITH AN "X" IN SECTION BOX: N  S	4	DEPTH OF WELL.... <u>1.75</u>ft. WELL'S STATIC WATER LEVEL.. <u>30</u>ft. <u>4 Heat Pump Wells</u> WELL WAS USED AS: 1 Domestic 5 Public Water Supply 9 Dewatering 2 Irrigation 6 Oil Field Water Supply 10 Monitoring Well 3 Feedlot 7 Lawn and Garden Only 11 Injection Well 4 Industrial 8 Air Conditioning <u>12 Other..Heat..Pump...</u> Was a chemical/bacteriological sample submitted to Department? Yes....No <u>X</u> .. If yes, mo/day/yr sample was submitted..... Water Well Disinfected: Yes <u>X</u> No.....
---	---	---	--

5	TYPE OF BLANK CASING USED: 1 Steel 3 RMP (SR) 5 Wrought 7 Fiberglass 9 Other (specify below) 2 PVC 4 ABS 6 Asbestos-Cement 8 Concrete Tile <u>Polyethene Pipe</u> Blank casing diameter... <u>3/4</u> ..in. Was casing pulled? Yes..... No..... If yes, how much..... Casing height above or below land surface.....in.
---	---

6	GROUT PLUG MATERIAL: 1 Neat cement 2 Cement grout <u>3 Bentonite</u> 4 Other..... Grout Plug Intervals: From..0..ft. to <u>1.75</u> ..ft., From.....ft. toft., From..... to.....ft. What is the nearest source of possible contamination: <u>Watertight Sewer Line</u> 1 Septic tank 6 Seepage pit 11 Fuel storage 16 Other (specify below) 2 Sewer lines 7 Pit privy 12 Fertilizer storage 3 Watertight sewer lines 8 Sewage lagoon 13 Insecticide storage 4 Lateral lines 9 Feedyard 14 Abandoned water well 5 Cess Pool 10 Livestock pens 15 Oil well/Gas well Direction from well? <u>South</u> How many feet? <u>100ft</u>
---	---

FROM	TO	PLUGGING MATERIALS
0	1	Top Soil
1	4	Tan Clay
4	6	Top Soil
6	21	Tan Clay
21	30	Fine Sandy Clay
30	44	Fine to Medium Sand
44	102	Shale-Dark Gray

102-175 Shale-Light Gray

7	CONTRACTOR'S OR LANDOWNER'S CERTIFICATION: This water well was plugged under my jurisdiction and was completed on (mo/day/year)..... <u>9-12-95</u> and this record is true to the best of my knowledge and belief. Kansas Water Well Contractor's License No. <u>138</u> This Water Well Record was completed on (mo/day/year) by (signature) .. <u>Mike Peterson</u> the business name of <u>Peterson Irrigation Inc.</u>
---	---

INSTRUCTIONS: Use typewriter or ball point pen. Please press firmly and print clearly. Please fill in blanks, underline or circle the correct answers. Send top three copies to Kansas Department of Health and Environment, Bureau of Water, Topeka, Kansas 66620-0001. Telephone: 913/296-3565. Send one to Water Well Owner and retain one for your records.