

2411027

MW-1

WATER WELL RECORD Form WWC-5 KSA 82a-1212


1 LOCATION OF WATER WELL:	Fraction	Section Number	Township Number	Range Number
County: <u>Sedgwick</u>	<u>SW 1/4 SW 1/4 SW 1/4</u>	<u>32</u>	<u>T 28 S</u>	<u>R 1 EW</u>

Distance and direction from nearest town or city street address of well if located within city?

140 N. Main Street, Haysville

2 WATER WELL OWNER:	Board of Agriculture, Division of Water Resources
RR#, St. Address, Box #:	Application Number:
<u>P.O. Box 500</u>	
City, State, ZIP Code:	

3 LOCATE WELL'S LOCATION WITH AN "X" IN SECTION BOX:	4 DEPTH OF COMPLETED WELL: <u>20.5</u> ft. ELEVATION: <u>1243.9 0 TOC</u>
--	---

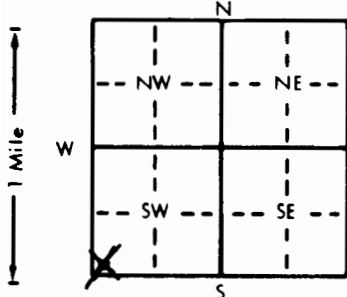

Depth(s) Groundwater Encountered: <u>1. 15.5</u> ft. 2. . ft. 3. . ft.
WELL'S STATIC WATER LEVEL: <u>15.24</u> ft. below land surface measured on mo/day/yr <u>10/8/96</u>
Pump test data: Well water was . ft. after . hours pumping . gpm
Est. Yield . gpm: Well water was . ft. after . hours pumping . gpm
Bore Hole Diameter: <u>8</u> in. to . ft., and . in. to . ft.
WELL WATER TO BE USED AS:
5 Public water supply 8 Air conditioning 11 Injection well
1 Domestic 3 Feedlot 6 Oil field water supply 9 Dewatering 12 Other (Specify below)
2 Irrigation 4 Industrial 7 Lawn and garden only <u>10 Monitoring well</u>
Was a chemical/bacteriological sample submitted to Department? Yes . No <u>X</u> . If yes, mo/day/yr sample was submitted
Water Well Disinfected? Yes . No <u>X</u>

5 TYPE OF BLANK CASING USED:	5 Wrought iron	8 Concrete tile	CASING JOINTS: Glued . Clamped .
1 Steel	3 RMP (SR)	6 Asbestos-Cement	9 Other (specify below)
<u>2 PVC</u>	4 ABS	7 Fiberglass	Welded .
Blank casing diameter: <u>2</u> in. to . ft., Dia . in. to . ft., Dia . in. to . ft.			<u>Threaded</u> <u>Flush</u>

Casing height above land surface: <u>flush</u> in., weight <u>0.703</u> lbs./ft. Wall thickness or gauge No. <u>Sch 40</u>
--

TYPE OF SCREEN OR PERFORATION MATERIAL:	<u>7 PVC</u>	10 Asbestos-cement
1 Steel	3 Stainless steel	5 Fiberglass
2 Brass	4 Galvanized steel	6 Concrete tile
3 RMP (SR)	9 ABS	11 Other (specify)
12 None used (open hole)		

SCREEN OR PERFORATION OPENINGS ARE:	5 Gauzed wrapped	8 Saw cut	11 None (open hole)
1 Continuous slot	3 Mill slot	6 Wire wrapped	9 Drilled holes
2 Louvered shutter	4 Key punched	7 Torch cut	10 Other (specify)

SCREEN-PERFORATED INTERVALS:	From <u>10.5</u> ft. to <u>20.5</u> ft.	From . ft. to . ft.
GRAVEL PACK INTERVALS:	From <u>8.5</u> ft. to <u>20.5</u> ft.	From . ft. to . ft.

6 GROUT MATERIAL:	1 Neat cement	2 Cement grout	<u>3 Bentonite</u>	4 Other
Grout Intervals: From . ft. to <u>8.5</u> ft.	From . ft. to . ft.	From . ft. to . ft.	From . ft. to . ft.	

What is the nearest source of possible contamination:	10 Livestock pens	14 Abandoned water well
1 Septic tank	4 Lateral lines	7 Pit privy
2 Sewer lines	5 Cess pool	8 Sewage lagoon
3 Watertight sewer lines	6 Seepage pit	9 Feedyard
		11 Fuel storage
		12 Fertilizer storage
		13 Insecticide storage
		15 Oil well/Gas well
		16 Other (specify below)

Direction from well? <u>NW</u>	How many feet? <u>~1, corner tank basin</u>
--------------------------------	---

FROM	TO	LITHOLOGIC LOG	FROM	TO	PLUGGING INTERVALS
<u>0</u>	<u>1.5</u>	<u>Topsoil, very fine to fine sand</u>			
<u>1.5</u>	<u>4</u>	<u>Clay</u>			
<u>4</u>	<u>7</u>	<u>Sand, very fine to fine grains</u>			
<u>7</u>	<u>14</u>	<u>Sand, very fine to medium grains</u>			
<u>14</u>	<u>20.5</u>	<u>Sand, medium to v. coarse grains</u>			

7 CONTRACTOR'S OR LANDOWNER'S CERTIFICATION: This water well was <u>(1) constructed</u> (2) reconstructed, or (3) plugged under my jurisdiction and was completed on (mo/day/year) <u>10/8/96</u> and this record is true to the best of my knowledge and belief. Kansas Water Well Contractor's License No. <u>531</u> This Water Well Record was completed on (mo/day/yr) <u>11-6-96</u> under the business name of <u>GSI</u> by (signature) <u>Candace Watson</u>

INSTRUCTIONS: Use typewriter or ball point pen. PLEASE PRESS FIRMLY and PRINT clearly. Please fill in blanks, underline or circle the correct answers. Send top three copies to Kansas Department of Health and Environment, Bureau of Water, Topeka, Kansas 66620-0001. Telephone: 913-296-5545. Send one to WATER WELL OWNER and retain one for your records.