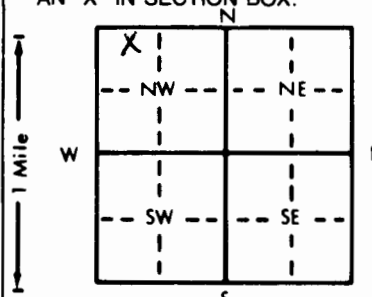


1 LOCATION OF WATER WELL: County: <u>Sedgewick</u>	Fraction <u>NE 1/4 NW 1/4 NW 1/4</u>	Section Number <u>17</u>	Township Number <u>T 28 S</u>	Range Number <u>R 1 E</u>
---	---	-----------------------------	----------------------------------	------------------------------

Distance and direction from nearest town or city street address of well if located within city?

901 W. MacArthur Rd., Wichita, KS

2 WATER WELL OWNER: <u>OXY Dist. Inc.</u> RR#, St. Address, Box #: <u>110 W. Seventh St.</u> City, State, ZIP Code: <u>Tulsa, OK 74119</u>	Board of Agriculture, Division of Water Resources Application Number:
--	--


--	---

GRAVEL PACK INTERVALS: From <u>5</u> ft. to <u>20</u> ft., 
--

6 GROUT MATERIAL: 1 Neat cement 2 Cement grout 3 Bentonite 4 Other Grout Intervals: <u>3</u> From <u>4</u> ft. to <u>5</u> ft., 1 From <u>3</u> ft. to <u>4</u> ft., 2 From <u>0</u> ft. to <u>3</u> ft. What is the nearest source of possible contamination: 1 Septic tank 4 Lateral lines 7 Pit privy 10 Livestock pens 14 Abandoned water well 2 Sewer lines 5 Cess pool 8 Sewage lagoon 11 Fuel storage 15 Oil well/Gas well 3 Watertight sewer lines 6 Seepage pit 9 Feedyard 12 Fertilizer storage 16 Other (specify below) <u>Former Fuel Storage</u> Direction from well? <u>Processing On Site</u> How many feet? <u>1-8-97</u>

FROM	TO	LITHOLOGIC LOG	FROM	TO	PLUGGING INTERVALS
0	2'	Sand, fine grain			
2'	8'	Silty sand, fine grain			
8'	15'	Clayey silty sand, med-fn. grain			
15'	20'	Sand with some clayey silt, coarse grain			

7 CONTRACTOR'S OR LANDOWNER'S CERTIFICATION: This water well was <u>(1)</u> constructed, (2) reconstructed, or (3) plugged under my jurisdiction and was completed on (mo/day/year) <u>12-16-96</u> thru <u>12-20-96</u> and this record is true to the best of my knowledge and belief. Kansas Water Well Contractor's License No. <u>603</u> This Water Well Record was completed on (mo/day/yr) <u>1-8-97</u> under the business name of <u>Whitetail Services, Inc.</u> by (signature) <u>Ed C. Schum</u>
