WATER WELL PLUGGING RECORD Form WWC-5P KSA 82a-1212

1 LOCATION OF WATER WELL:	Fraction	Section Number	Township Number	Range Number
County: Sedgwick	NW 1/4 SW1/4 SE1/4	16	T28S	R1E

Distance and direction from nearest town or city street address of well if located within city?
19 ft. west of NW corner of 4641 S. Ida

2 WATER WELL OWNER: Chet Shellenberger
10040 E. Happy Valley Rd.
RR#, St. Address, Box #: Unit 602
City, State, ZIP Code : Scottsdale, AZ 85255
Board of Agriculture, Division of Water Resources
Application Number: Unkown

3 MARK WELL'S LOCATION WITH AN "X" IN SECTION BOX:

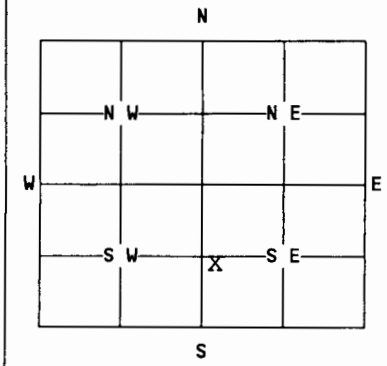

4 DEPTH OF WELL 15 ft.

WELL'S STATIC WATER LEVEL 12 ft.

WELL WAS USED AS:

1 Domestic 5 Public Water Supply 9 Dewatering
2 Irrigation 6 Oil Field Water Supply 10 Monitoring Well
3 Feedlot XX Lawn and Garden Only 11 Injection Well
4 Industrial 8 Air Conditioning 12 Other.....

Was a chemical/bacteriological sample submitted to Department? Yes....No.X.
If yes, mo/day/yr sample was submitted.....

Water Well Disinfected: Yes.X.... No.....

5 TYPE OF BLANK CASING USED:

X1 Steel 3 RMP (SR) 5 Wrought 7 Fiberglass 9 Other (specify below)
2 PVC 4 ABS 6 Asbestos-Cement 8 Concrete Tile .....

Blank casing diameter 2 in. Was casing pulled? Yes..... No.X... If yes, how much.....
Casing height ~~above~~ or below land surface 1 in.

6 GROUT PLUG MATERIAL: 1 Neat cement X Cement grout X Bentonite 4 Other.....

Grout Plug Intervals: From 15 ft. to 0 ft., From.....ft. to .....ft., From..... to.....ft.

What is the nearest source of possible contamination:

X1 Septic tank 6 Seepage pit 11 Fuel storage XX Other (specify below)
X2 Sewer lines 7 Pit privy 12 Fertilizer storage termite treatment.
3 Watertight sewer lines 8 Sewage lagoon 13 Insecticide storage
4 Lateral lines 9 Feedyard 14 Abandoned water well
5 Cess Pool 10 Livestock pens 15 Oil well/Gas well

Direction from well? west How many feet? 1

FROM	TO	PLUGGING MATERIALS
2	0	cement
15	2	bentonite/bleach

7 CONTRACTOR'S OR LANDOWNER'S CERTIFICATION: This water well was plugged under my jurisdiction and was completed on (mo/day/year) 8/20/97 and this record is true to the best of my knowledge and belief. Kansas Water Well Contractor's License No. pending This Water Well Record was completed on (mo/day/year) 8/20/97 under the business name of .....
by (signature) .....

INSTRUCTIONS: Use typewriter or ball point pen. Please press firmly and print clearly. Please fill in blanks, underline or circle the correct answers. Send top three copies to Kansas Department of Health and Environment, Bureau of Water, Topeka, Kansas 66620-0001. Telephone: 913/296-3565. Send one to Water Well Owner and retain one for your records.