


1 LOCATION OF WATER WELL: Sedgwick <i>SW</i>	FRACTION SE 1/4 NE 1/4 NE 1/4	Section Number 33	Township Number T 28 S	Range Number R 1E E/W
--	---	-----------------------------	----------------------------------	---------------------------------

Distance and direction from nearest town or city street address of well if located within city?

6555 S. Hydraulic Wichita, Kansas

WATER WELL OWNER: TAYLOR, Loren	Board of Agriculture, Division of Water Resource
RR#, ST. ADDRESS, BOX #: 6555 S. Hydraulic	Application Number:
CITY, STATE, ZIP CODE: Wichita, Kansas	

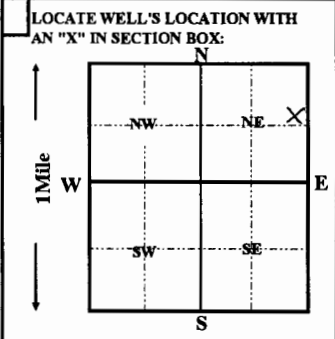

4 DEPTH OF COMPLETED WELL 43 ft.	ELEVATION:		
Depth(s) groundwater Encountered 1 ft.	2 ft.	3 ft.	
WELL'S STATIC WATER LEVEL 15 FT. BELOW LAND SURFACE MEASURED ON 08/31/1999		mo/day/yr	
Pump test data: Well water was _____ ft. after _____ hours pumping _____ gpm			
Est. Yield _____ gpm: Well water was _____ ft. after _____ hours pumping _____ gpm			
Bore Hole Diameter 12 in. to 43 ft. and _____ in. to _____ ft.			
WELL WATER TO BE USED AS: 5 Public water supply 8 Air conditioning 11 Injection well			
1 Domestic 3 Feedlot 6 Oil field water supply 9 Dewatering 12 Other (Specify below)			
2 Irrigation 4 Industrial 7 Lawn and garden only 10 Monitoring well			
Was a chemical/bacteriological sample submitted to Department? Yes _____ No X ; if yes, mo/day/yr sample was submitted _____			
Water Well Disinfected? Yes X No _____			

5 TYPE OF CASING USED:		5 Wrought iron	8 Concrete tile	CASING JOINTS:	Glued X Clamped
1 Steel	3 RMP (SR)	6 Asbestos-Cement	9 Other (Specify below)		Welded
2 PVC	4 ABS	7 Fiberglass	SDR - 26		Threaded
Blank casing Diameter 5 in. to 28 ft., Dia _____ in. to _____ ft.		weight 2.35 lbs. / ft.		Wall thickness or gauge No. .214	
Casing height above land surface 12 in., _____					
TYPE OF SCREEN OR PERFORATION MATERIAL:					
1 Steel	3 Stainless Steel	5 Fiberglass	8 RMP (SR)	11 other (specify)	
2 Brass	4 Galvanized steel	6 Concrete tile	9 ABS	12 None used (open hole)	
SCREEN OR PERFORATION OPENING ARE:					
1 Continuous slot	3 Mill slot	5 Gauzed wrapped	8 Saw cut	11 None (open hole)	
2 Louvered shutter	4 Key punched	6 Wire wrapped	9 Drilled holes		
7 Torch cut	10 Other (specify)				
SCREEN-PERFORATION INTERVALS:					
from 28 ft.	ft. to 38	ft., From _____	ft. to _____	ft.	ft.
GRAVEL PACK INTERVALS:	from 26 ft.	ft. to 43	ft., From _____	ft. to _____	ft.
from _____	ft. to _____	ft., From _____	ft. to _____	ft.	ft.

6 GROUT MATERIAL: 1 Neat cement		2 Cement grout	3 Bentonite	4 Other bentonite hole plug
Grout Intervals: From 4 ft. to 24 ft.		ft. From _____	ft. to _____	ft. From 24 ft. to 26 ft.
What is the nearest source of possible contamination:				
1 Septic tank	4 Lateral lines	7 Pit privy	10 Livestock pens	14 Abandon water well
2 Sewer lines	5 Cess pool	8 Sewage lagoon	11 Fuel storage	15 Oil well/Gas well
3 Watertight sewer lines	6 Seepage pit	9 Feedyard	12 Fertilizer storage	16 Other (specify below)
			13 Insecticide storage	None Apparent

Direction from well?		How many feet?			
FROM	TO	LITHOLOGIC LOG	FROM	TO	PLUGGING INTERVALS
0	2	topsoil			
2	8	clay			
8	40	medium coarse sand			
40	43	shale			

7 CONTRACTOR'S OR LANDOWNER'S CERTIFICATION: This water well was (1) constructed, (2) reconstructed, or (3) plugged under my jurisdiction and was completed on (mo/day/year) 08/31/1999 and this record is true to the best of my knowledge and belief. Kansas Water Well Contractor's License No. 236 This Water Well Record was completed on (mo/day/yr) 09/01/99	
Under the business name of Harp Well & Pump Service, Inc. by (signature)	<i>Todd S. Harp</i>