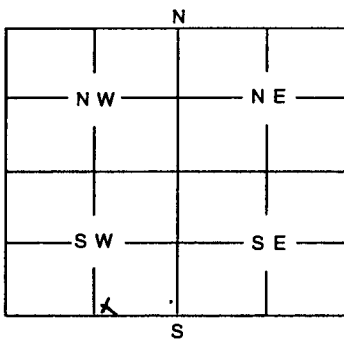


1	LOCATION OF WATER WELL:	Fraction	Section	Number	Township	Number	Range	Number
	County: Sedgwick	SE 1/4 SW 1/4 SW 1/4	8		28S		1E	

Distance and direction from nearest town or city street address of well if located within city?

901 W MACARTHUR, WICHITA, KS

2	WATER WELL OWNER: Oxy USA / Glenn Springs Holdings	
	RR #, St. Address, Box #: 2430 Fortune Dr. Ste 300	Board of Agriculture, Division of Water Resources
	City, State, ZIP Code: Lexington, Kentucky 40509	Application Number:

3	MARK WELL'S LOCATION WITH AN "X" IN SECTION BOX:	4	DEPTH OF WELL 20.0 ft
			WELL'S STATIC WATER LEVEL 16.0 ft.
			WELL WAS USED AS:
			1 Domestic 2 Irrigation 3 Feedlot 4 Industrial 5 Public Water Supply 6 Oil Field Water Supply 7 Domestic (Lawn & Garden) 8 Air Conditioning 9 Dewatering 10 Monitoring Well 11 Injection Well 12 Other
			Was a chemical / bacteriological sample submitted to Department? Yes No ☒
			If yes, mo/day/yr sample was submitted
			Water Well Disinfected: Yes No ☒

5	TYPE OF BLANK CASING USED:	
	1 Steel 2 PVC 3 RMP (SR) 4 ABS 5 Wrought 6 Asbestos-Cement 7 Fiberglass 8 Concrete Tile 9 Other (Specify below)	
	Blank casing diameter 2.0 in. Was casing pulled? Yes No If yes, how much	
	Casing height above or below land surface in.	

6	GROUT PLUG MATERIAL: 1 Neat cement 2 Cement grout 3 Bentonite 4 Other	
	Grout Plug Intervals: From ft. to ft., From ft. to ft., From ft. to ft.	
	What is the nearest source of possible contamination:	
	1 Septic tank 2 Sewer lines 3 Watertight sewer lines 4 Lateral lines 5 Cess Pool 6 Seepage pit 7 Pit privy 8 Sewage lagoon 9 Feedyard 10 Livestock pens 11 Fuel storage 12 Fertilizer storage 13 Insecticide storage 14 Abandoned water well 15 Oil well/Gas well 16 Other (specify below) Former NGL Facility	
	Direction from well? N/A How many feet? 0	

FROM	TO	PLUGGING MATERIALS
20.0	10.0	Bentonite Grout
10.0	3.0	Cement Grout 5 Per Bentonite
3.0	0.0	Soil

7	CONTRACTOR'S OR LANDOWNER'S CERTIFICATION: This water well was plugged under my jurisdiction and was completed on (mo/day/year) 2-2-01 and this record is true to the best of my knowledge and belief. Kansas Water Well Contractor's License No. 607 This Water Well Record was completed on (mo/day/year) 3-5-01 under the business name of Davis Environmental Drilling, LLC by (signature) [Signature]	
---	--	--

INSTRUCTIONS: Use typewriter or ball point pen. Please press firmly and print clearly. Please fill in blanks, underline or circle the correct answers. Send top three copies to Kansas Department of Health and Environment, Bureau of Water, Topeka, Kansas 66620-0001. Telephone: 785/296-3565. Send one to Water Well Owner and retain one for your records.