

CORRECTION TO WATER WELL RECORD (WWC-5)

The following correction(s) was made to the attached WWC-5 log in order to rectify lacking or incorrect information.

Fraction (1/4 1/4 1/4) Section-Township-Range changed:

listed as No legal description given

changed to SW SW SE, 18-28S-1E

Other changes: Initial statements: _____

Changed to: _____

Comments: Street address is 4746 S. Glenn St.

verification method: Well address, city map, and
Wichita East 1:24,000 topo. map.

initials: DRL date: 12/5/2002

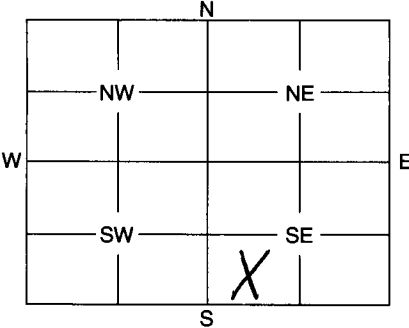
submitted by: Kansas Geological Survey, Data Resources Library, 1930 Constant Ave., Lawrence, KS 66047-3726
to: Kansas Dept of Health & Environment Bureau of Water Industrial Programs, Bldg 283, Forbes Field, KS 66620

1	LOCATION OF WATER WELL:	Fraction	Section	Number	Township	Number	Range	Number
County: <u>Sedgwick</u>		$\frac{1}{4}$ $\frac{1}{4}$ $\frac{1}{4}$						E/W

Distance and direction from nearest town or city street address of well if located within city?

4746 South Allen, Wichita, Kansas 67212

2	WATER WELL OWNER: <u>Mark Kimberly Blanton</u>	Board of Agriculture, Division of Water Resources
RR #, St. Address, Box #: <u>4746 S. Allen</u>		Application Number:
City, State, ZIP Code: <u>WICHITA, KS 67217</u>		

3	MARK WELL'S LOCATION WITH AN "X" IN SECTION BOX:	4	DEPTH OF WELL <u>20</u> ft.
		WELL'S STATIC WATER LEVEL <u>12</u> ft. WELL WAS USED AS: 1 Domestic 5 Public Water Supply 9 Dewatering 2 Irrigation 6 Oil Field Water Supply 10 Monitoring Well 3 Feedlot 7 Domestic (Lawn & Garden) 11 Injection Well 4 Industrial 8 Air Conditioning 12 Other	
Was a chemical / bacteriological sample submitted to Department? Yes No			
If yes, mo/day/yr sample was submitted			
Water Well Disinfected: Yes <u>X</u> No			

5	TYPE OF BLANK CASING USED:			
1 Steel 3 RMP (SR) 5 Wrought 7 Fiberglass 9 Other (Specify below) 2 PVC 4 ABS 6 Asbestos-Cement 8 Concrete Tile				
Blank casing diameter <u>1 1/4</u> in. Was casing pulled? Yes No <u>X</u> If yes, how much				
Casing height above or below land surface: <u>flush w/land</u>				

6	GROUT PLUG MATERIAL: <u>1 Neat cement</u> 2 Cement grout 3 Bentonite 4 Other
Grout Plug Intervals: From <u>20</u> ft. to <u>0</u> ft., From ft. to ft., From to ft.	
What is the nearest source of possible contamination:	
1 Septic tank 6 Seepage pit 11 Fuel storage 16 Other (specify below) 2 Sewer lines 7 Pit privy 12 Fertilizer storage 3 Watertight sewer lines 8 Sewage lagoon 13 Insecticide storage 4 Lateral lines 9 Feedyard 14 Abandoned water well 5 Cess pool 10 Livestock pens 15 Oil well/Gas well	
Direction from well? <u>South</u> How many feet?	

FROM	TO	PLUGGING MATERIALS
<u>20</u>	<u>0</u>	<u>Neat Cement</u>

7	CONTRACTOR'S OF LANDOWNER'S CERTIFICATION: This water well was plugged under my jurisdiction and was completed on (mo/day/year) <u>8/18/02</u> and this record is true to the best of my knowledge and belief. Kansas Water Well Contractor's License No. This Water Well Record was completed on (mo/day/year)
by (signature) <u>Mark J. Blanton</u> under the business name of	

INSTRUCTIONS: Use typewriter or ball point pen. Please press firmly and print clearly. Please fill in blanks, underline or circle the correct answers. Send top three copies to Kansas Department of Health and Environment, Bureau of Water, Geology Section, 1000 SW Jackson St., Ste. 420, Topeka, Kansas 66612-1367. Telephone: 785/296-5522. Send one to Water Well Owner and retain one for your records.