

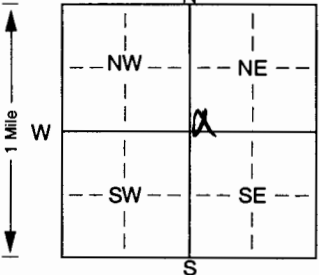
017146

WATER WELL RECORD

Form WWC-5

KSA 82a-1212 ID No.

MW-108

|   |             |   |                   |                         |                                       |
|---|-------------|---|-------------------|-------------------------|---------------------------------------|
| 1 LOCATION OF WATER WELL:   |             | Fraction   | Section Number    | Township Number         | Range Number                          |
| County: <u>Sedgwick</u>   |             | <u>SW 1/4 SW 1/4 NE 1/4</u>   | <u>29</u>         | <u>T 28 S</u>           | <u>R 1 E</u>                          |
| Distance and direction from nearest town or city street address of well if located within city?<br><u>2 blocks west of 59th &amp; Broadway, Derby</u>   |             |   |                   |                         |                                       |
| 2 WATER WELL OWNER: <u>Kansas Corporation Commission</u>   |             |   |                   |                         |                                       |
| RR#, St. Address, Box #: <u>130 S. Market Rm 2125</u>   |             |   |                   |                         |                                       |
| City, State, ZIP Code: <u>Wichita KS 67202</u>   |             |   |                   |                         |                                       |
| Board of Agriculture, Division of Water Resources<br>Application Number:   |             |   |                   |                         |                                       |
|   |             | WELL WATER TO BE USED AS: 5 Public water supply 8 Air conditioning 11 Injection well                                               |                   |                         |                                       |
|   |             | 1 Domestic 3 Feedlot 6 Oil field water supply 9 Dewatering 12 Other (Specify below)                                                |                   |                         |                                       |
|   |             | 2 Irrigation 4 Industrial 7 Domestic (lawn & garden) <u>10 Monitoring well</u>                                                     |                   |                         |                                       |
| 5 TYPE OF BLANK CASING USED:   |             |   |                   |                         |                                       |
| 1 Steel   |             | 3 RMP (SR)   | 5 Wrought iron    | 8 Concrete tile         | CASING JOINTS: Glued. <u>Clamped.</u> |
| 2 PVC   |             | 4 ABS   | 6 Asbestos-Cement | 9 Other (specify below) | Welded <u>Threaded</u>                |
|   |             |   | 7 Fiberglass      |                         | <u>Flush</u>                          |
| Casing height above land surface <u>36</u> in., weight <u>70.3</u> lbs./ft. Wall thickness or gauge No. <u>Sch 40</u>   |             |   |                   |                         |                                       |
| TYPE OF SCREEN OR PERFORATION MATERIAL:   |             |   |                   |                         |                                       |
| 1 Steel   |             | 3 Stainless steel   | 5 Fiberglass      | 7 PVC                   | 10 Asbestos-cement                    |
| 2 Brass   |             | 4 Galvanized steel   | 6 Concrete tile   | 8 RMP (SR)              | 11 Other (specify)                    |
|   |             |   |                   | 9 ABS                   | 12 None used (open hole)              |
| SCREEN OR PERFORATION OPENINGS ARE:   |             |   |                   |                         |                                       |
| 1 Continuous slot   |             | 3 Mill slot   | 5 Gauzed wrapped  | 8 Saw cut               | 11 None (open hole)                   |
| 2 Louvered shutter   |             | 4 Key punched   | 6 Wire wrapped    | 9 Drilled holes         |                                       |
|   |             |   | 7 Torch cut       | 10 Other (specify)      |                                       |
| 6 GROUT MATERIAL: 1 Neat cement 2 Cement grout 3 Bentonite 4 Other   |             |   |                   |                         |                                       |
| What is the nearest source of possible contamination:   |             |   |                   |                         |                                       |
| 1 Septic tank   |             | 4 Lateral lines   | 7 Pit privy       | 10 Livestock pens       | 14 Abandoned water well               |
| 2 Sewer lines   |             | 5 Cess pool   | 8 Sewage lagoon   | 11 Fuel storage         | 15 Oil well/Gas well                  |
| 3 Watertight sewer lines   |             | 6 Seepage pit   | 9 Feedyard        | 12 Fertilizer storage   | 16 Other (specify below)              |
|   |             |   |                   | 13 Insecticide storage  |                                       |
| Direction from well? How many feet?   |             |   |                   |                         |                                       |
| FROM   | TO          | LITHOLOGIC LOG   | FROM              | TO                      | PLUGGING INTERVALS                    |
| <u>0</u>   | <u>2</u>    | <u>Sandy clay, br</u>   |                   |                         |                                       |
| <u>2</u>   | <u>4</u>    | <u>Sandy silt, br</u>   |                   |                         |                                       |
| <u>4</u>   | <u>6</u>    | <u>Silt, br</u>   |                   |                         |                                       |
| <u>6</u>   | <u>11.5</u> | <u>Sandy silt, tan</u>   |                   |                         |                                       |
| <u>11.5</u>   | <u>18</u>   | <u>Sand, f to m</u>   |                   |                         |                                       |
| <u>18</u>   | <u>52</u>   | <u>Sand, m to vc</u>   |                   |                         |                                       |
| <u>52</u>   | <u>52.6</u> | <u>Shale, weathered, gray</u>   |                   |                         |                                       |
| 7 CONTRACTOR'S OR LANDOWNER'S CERTIFICATION: This water well was (1) constructed, (2) reconstructed, or (3) plugged under my jurisdiction and was completed on (mo/day/year) <u>4/30/02</u> and this record is true to the best of my knowledge and belief. Kansas Water Well Contractor's Licence No. <u>531</u> This Water Well Record was completed on (mo/day/yr) <u>5/29/02</u> under the business name of <u>Geotechnical Services, Inc.</u> by (signature) <u>William M. Shi</u> |             |   |                   |                         |                                       |
| INSTRUCTIONS: Use typewriter or ball point pen. PLEASE PRESS FIRMLY and PRINT clearly. Please fill in blanks, underline or circle the correct answers. Send top three copies to Kansas Department of Health and Environment, Bureau of Water, Topeka, Kansas 66620-0001. Telephone 785-296-5524. Send one to WATER WELL OWNER and retain one for your records. Fee of \$5.00 for each constructed well.                                                                                 |             |   |                   |                         |                                       |