

RW-211 007260

WATER WELL RECORD

Form WWC-5

KSA 82a-1212 ID No.

1 LOCATION OF WATER WELL:	Fraction	Section Number	Township Number	Range Number
County: Sedgwick	SE 1/4 SE 1/4 NW 1/4	11	T 28 S	R 1 EW

Distance and direction from nearest town or city street address of well if located within city?

North of the north entry/exit ramp of the Kansas turnpike at K-15

2 WATER WELL OWNER: Boeing

RR#, St. Address, Box #: PO Box 7730

City, State, ZIP Code: Wichita, KS 67277-7730


Board of Agriculture, Division of Water Resources

Application Number:

3 LOCATE WELL'S LOCATION WITH

4 DEPTH OF COMPLETED WELL: 48 ft. ELEVATION:

AN "X" IN SECTION BOX:

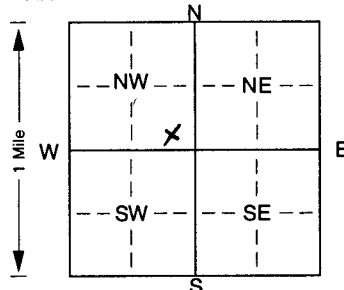

Depth(s) Groundwater Encountered 1. 36.5 ft. 2. ft. 3. ft.

WELL'S STATIC WATER LEVEL 38.5 ft. below land surface measured on mo/day/yr

Pump test data: Well water was ft. after hours pumping gpm

Est. Yield gpm: Well water was ft. after hours pumping gpm

Bore Hole Diameter 16.5 in. to 48 ft. and in. to ft.

WELL WATER TO BE USED AS: 5 Public water supply 8 Air conditioning 11 Injection well

1 Domestic 3 Feedlot 6 Oil field water supply 9 Dewatering

2 Irrigation 4 Industrial 7 Domestic (lawn & garden) 10 Monitoring well 12 Other (Specify below)

Recovery well RW-211

Was a chemical/bacteriological sample submitted to Department? Yes. No. X; If yes, mo/day/yr sample was submitted

Water Well Disinfected? Yes No X

5 TYPE OF BLANK CASING USED:

1 Steel 3 RMP (SR)

2 PVC 4 ABS

5 Wrought iron

6 Asbestos-Cement

7 Fiberglass

8 Concrete tile

9 Other (specify below)

CASING JOINTS: Glued. Clamped.

Welded

Threaded

Blank casing diameter 5 in. to 28 ft. Dia. in. to ft. Dia. in. to ft.

Casing height above land surface flush in., weight 2.77 lbs./ft. Wall thickness or gauge No. Sch 40

TYPE OF SCREEN OR PERFORATION MATERIAL:

1 Steel 3 Stainless steel

2 Brass 4 Galvanized steel

5 Fiberglass

6 Concrete tile

7 PVC

8 RMP (SR)

9 ABS

10 Asbestos-cement

11 Other (specify)

12 None used (open hole)

SCREEN OR PERFORATION OPENINGS ARE:

1 Continuous slot

2 Louvered shutter

3 Mill slot

4 Key punched

5 Gauzed wrapped

6 Wire wrapped

7 Torch cut

8 Saw cut

9 Drilled holes

10 Other (specify) ft.

11 None (open hole)

SCREEN-PERFORATED INTERVALS: From 28 ft. to 48 ft. From ft. to ft. From ft. to ft.

GRAVEL PACK INTERVALS: From 25 ft. to 48 ft. From ft. to ft. From ft. to ft.

6 GROUT MATERIAL:

1 Neat cement

2 Cement grout

3 Bentonite

4 Other

Grout Intervals: From 4 ft. to 25 ft. From ft. to ft. From ft. to ft.

What is the nearest source of possible contamination:

1 Septic tank

4 Lateral lines

7 Pit privy

10 Livestock pens

14 Abandoned water well

2 Sewer lines

5 Cess pool

8 Sewage lagoon

11 Fuel storage

15 Oil well/Gas well

3 Watertight sewer lines

6 Seepage pit

9 Feedyard

12 Fertilizer storage

16 Other (specify below)

13 Insecticide storage

Direction from well?

How many feet?

FROM	TO	LITHOLOGIC LOG	FROM	TO	PLUGGING INTERVALS
0	26	Silty clay, brown			
26	28	Sandy clay, light brown			
28	33	Sand, fine to medium grain			
33	35	Sandstone			
35	40	Sand, fine to medium grain			
40	44	Weathered Shale, olive			
44	48	Shale, dark gray			

7 CONTRACTOR'S OR LANDOWNER'S CERTIFICATION: This water well was (1) constructed, (2) reconstructed, or (3) plugged under my jurisdiction and was completed on (mo/day/year) 7/15/02 and this record is true to the best of my knowledge and belief. Kansas

Water Well Contractor's Licence No. 531

This Water Well Record was completed on (mo/day/yr) 7/22/02

under the business name of Geotechnical Services, Inc.

by (signature)

John C. Gonsky

INSTRUCTIONS: Use typewriter or ball point pen. PLEASE PRESS FIRMLY and PRINT clearly. Please fill in blanks, underline or circle the correct answers. Send top three copies to Kansas Department of Health and Environment, Bureau of Water, Topeka, Kansas 66620-0001. Telephone 785-296-5524. Send one to WATER WELL OWNER and retain one for your records. Fee of \$5.00 for each constructed well.