

WATER WELL PLUGGING RECORD

Form WWC-5P

KSA 82a-1212

ID No.

1 LOCATION OF WATER WELL:	Fraction	Section Number	Township Number	Range Number
County: Sedgwick	SE ¼ NW ¼ SW ¼	12	28 S	1 E

Distance and direction from nearest town or city street address of well if located within city?

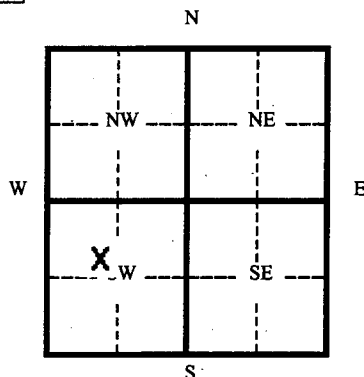
3801 S. Oliver, East of Boeing Building 4-23L, Wichita, KS2 WATER WELL OWNER: **Boeing Company**RR#, St. Address, Box # **P.O. Box 7730**

Board of Agriculture, Division of Water Resources

City, State, ZIP Code : **Wichita, KS 67277-7730**

Application Number:

3 MARK WELL'S LOCATION WITH AN "X" IN SECTION BOX:

4 DEPTH OF WELL **60** ft.WELL'S STATIC WATER LEVEL **14.40** ft.

WELL WAS USED AS:

1 Domestic

5 Public Water Supply

9 Dewatering

2 Irrigation

6 Oil Field Water Supply

10 Monitoring Well

3 Feedlot

7 Lawn and Garden (domestic)

11 Injection Well

4 Industrial

8 Air Conditioning

12 Other Recovery WellWas a chemical/bacteriological sample submitted to Department? Yes No **X**

If yes, mo/day/yr sample was submitted

Water Well Disinfected: Yes No **X**

5 TYPE OF BLANK CASING USED:

1 Steel

3 RMP (SR)

5 Wrought

7 Fiberglass

9 Other (specify below)

2 PVC

4 ABC

6 Asbestos-Cement

8 Concrete Tile

Blank casing diameter **5** in.Was casing pulled? Yes No **X**

If yes, how much

Casing height above or below land surface **40** in.**Overdrilled 20'.**6 GROUT PLUG MATERIAL: 1 Neat cement 2 Cement grout **3 Bentonite** 4 OtherGrout Plug Intervals From **1** ft. to **60** ft. From ft. to ft. From ft.

What is the nearest source of possible contamination:

1 Septic tank

6 Seepage pit

11 Fuel storage

16 Other (specify below)

2 Sewer lines

7 Pit privy

12 Fertilizer storage

N/A

3 Watertight sewer lines

8 Sewage lagoon

13 Insecticide storage

4 Lateral lines

9 Feedyard

14 Abandoned water well

5 Cess Pool

10 Livestock pens

15 Oil well/ Gas well

Direction from well? **N/A**How many feet? **N/A**

FROM	TO	CODE	PLUGGING MATERIALS
0	1		Soil
1	60		Bentonite Chips

7 CONTRACTOR'S OR LANDOWNER'S CERTIFICATION: This water well was plugged under my jurisdiction and was completed on (mo/day/yr) **10/14/02** and this record is true to the best of my knowledge and belief. KansasWater Well Contractor's License No. **531**

This Water Well Record was completed on (mo/day/yr)

11/6/02

under the business name of

Geotechnical Services, Inc.

by (signature)

INSTRUCTIONS: Please fill in blanks and circle the correct answers. Send three copies to Kansas Department of Health and Environment, Bureau of Water, 1000 S W Jackson St., Ste. 420, Topeka, Kansas 66620-0001. Telephone: 785-296-3565. Send one to Water Well Owner and retain one for your records.