

CORRECTION(S) TO WATER WELL RECORD (WWC-5)

(to rectify lacking or incorrect information)

County: Sedgwick

Location listed as:

Section-Township-Range: 29-285-W-26

Fraction ($\frac{1}{4}$ $\frac{1}{4}$ $\frac{1}{4}$): NE NE SW

Location changed to:

29-285-1E

SE NW SW

Other changes: Initial statements: _____

Changed to: _____

Comments: _____

verification method: well owner's address, legal description, city map,
and Derby 1:24,000 topo. map.

initials: DRA date: 7/8/2004

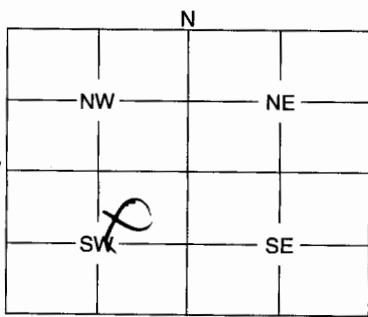
submitted by: Kansas Geological Survey, Data Resources Library, 1930 Constant Ave., Lawrence, KS 66047-3726

to: Kansas Dept of Health & Environment, Bureau of Water, 1000 SW Jackson, Suite 420, Topeka, KS 66612-1367.

1	LOCATION OF WATER WELL:	Fraction	Section Number	Township Number	Range Number
	County: <u>Sedgwick</u>	<u>NE 1/4</u> <u>1/4 NE 1/4 SW</u>	<u>29</u>	<u>T28 S</u>	<u>W-26</u> EW

Distance and direction from nearest town or city street address of well if located within city?

2	WATER WELL OWNER: <u>BILL CASTLEBERG</u>	Board of Agriculture, Division of Water Resources
	RR #, St. Address, Box #: <u>6007 S. OSAGE</u>	Application Number: _____
	City, State, ZIP Code: <u>WICHITA KS 67217</u>	

3	MARK WELL'S LOCATION WITH AN "X" IN SECTION BOX:	4	DEPTH OF WELL <u>253</u> ft. WELL'S STATIC WATER LEVEL <u>10' 5"</u> ft. WELL WAS USED AS: ☒ Domestic ☐ Irrigation ☐ Feedlot ☐ Industrial ☐ Public Water Supply ☐ Oil Field Water Supply ☐ Domestic (Lawn & Garden) ☐ Air Conditioning ☐ Dewatering ☐ Monitoring Well ☐ Injection Well ☐ Other _____
		Was a chemical / bacteriological sample submitted to Department? Yes _____ No ☒ If yes, mo/day/yr sample was submitted _____ Water Well Disinfected: Yes ☒ No _____	

5	TYPE OF BLANK CASING USED:
	1 Steel 3 RMP (SR) 5 Wrought 7 Fiberglass 9 Other (Specify below) ☒ PVC 4 ABS 6 Asbestos-Cement 8 Concrete Tile
	Blank casing diameter <u>6</u> in. Was casing pulled? Yes _____ No ☒ If yes, how much _____
	Casing height above or below land surface <u>3</u> in.

6	GROUT PLUG MATERIAL: 1 Neat cement 2 Cement grout 3 Bentonite 4 Other _____
	Grout Plug Intervals: From <u>25</u> ft. to <u>3</u> ft., From _____ ft. to _____ ft., From _____ ft. to _____ ft.
	What is the nearest source of possible contamination:
	1 ☒ Septic tank 6 Seepage pit 11 Fuel storage 16 Other (specify below) _____ 2 Sewer lines 7 Pit privy 12 Fertilizer storage 3 Watertight sewer lines 8 Sewage lagoon 13 Insecticide storage 4 Lateral lines 9 Feedyard 14 Abandoned water well 5 Cess pool 10 Livestock pens 15 Oil well/Gas well
	Direction from well? <u>West</u> How many feet? <u>75'</u>

FROM	TO	PLUGGING MATERIALS
25'	3'	Cement Grout
3	0	Compacted Soil

7	CONTRACTOR'S OF LANDOWNER'S CERTIFICATION: This water well was plugged under my jurisdiction and was completed on (mo/day/year) <u>8/18/2004</u> and this record is true to the best of my knowledge and belief. Kansas Water Well Contractor's License No. _____ This Water Well Record was completed on (mo/day/year) _____ under the business name of _____ by (signature) <u>[Signature]</u>
---	--

INSTRUCTIONS: Use typewriter or ball point pen. Please press firmly and print clearly. Please fill in blanks, underline or circle the correct answers. Send top three copies to Kansas Department of Health and Environment, Bureau of Water, Geology Section, 1000 SW Jackson St., Ste. 420, Topeka, Kansas 66612-1367. Telephone: 785/296-5522. Send one to Water Well Owner and retain one for your records.