

1	LOCATION OF WATER WELL:	Fraction	Section Number	Township Number	Range Number
	County: Sedgwick	SE 1/4 SW 1/4 NE 1/4	14	28 S	01 E

Distance and direction from nearest town or city street address of well if located within city?
2801 S. Oliver – Boeing SW of SW corner IPB 3 Building

2	WATER WELL OWNER:	Boeing Company
	RR#, St. Address, Box #	PO Box 7730
	City, State, ZIP Code :	Wichita, KS 67277-7730
		Board of Agriculture, Division of Water Resources
		Application Number:

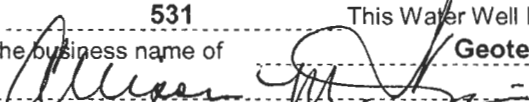
3	MARK WELL'S LOCATION WITH AN "X" IN SECTION BOX:
	N NW NE SW SE W X E S

4	DEPTH OF WELL	53	ft.
	WELL'S STATIC WATER LEVEL	32.7	ft.
	WELL WAS USED AS:		
	1 Domestic	5 Public Water Supply	9 Dewatering
	2 Irrigation	6 Oil Field Water Supply	10 Monitoring Well
	3 Feedlot	7 Lawn and Garden (domestic)	11 Injection Well
	4 Industrial	8 Air Conditioning	12 Other Recovery Well
	Was a chemical/bacteriological sample submitted to Department?	Yes	No X
	If yes, mo/day/yr sample was submitted		
	Water Well Disinfected:	Yes	No X

5	TYPE OF BLANK CASING USED:	
	1 Steel	3 RMP (SR)
	2 PVC	4 ABC
	5 Wrought	7 Fiberglass
	6 Asbestos-Cement	8 Concrete Tile
	9 Other (specify below)	
	Blank casing diameter	5 in.
	Was casing pulled?	Yes No X If yes, how much
	Casing height above or below land surface	240 in. Overdrilled to 20 ft below ground surface

6	GROUT PLUG MATERIAL:	1 Neat cement	2 Cement grout	3 Bentonite	4 Other		
	Grout Plug Intervals	From 0 ft. to 53 ft.	From	ft. to	ft. From	ft. to	ft.
	What is the nearest source of possible contamination:						
	1 Septic tank	6 Seepage pit	11 Fuel storage	16 Other (specify below)			
	2 Sewer lines	7 Pit privy	12 Fertilizer storage				
	3 Watertight sewer lines	8 Sewage lagoon	13 Insecticide storage				
	4 Lateral lines	9 Feedyard	14 Abandoned water well				
	5 Cess Pool	10 Livestock pens	15 Oil well/ Gas well				
	Direction from well?		How many feet?				

FROM	TO	CODE	PLUGGING MATERIALS
0	53		Bentonite

7	CONTRACTOR'S OR LANDOWNER'S CERTIFICATION: This water well was plugged under my jurisdiction and was completed on (mo/day/yr) 11-15-04 and this record is true to the best of my knowledge and belief. Kansas Water Well Contractor's License No. 531 This Water Well Record was completed on (mo/day/yr) 12-6-04 under the business name of Geotechnical Services, Inc. by (signature) 
---	--

INSTRUCTIONS: Please fill in blanks and circle the correct answers. Send three copies to Kansas Department of Health and Environment, Bureau of Water, 1000 S W Jackson St., Ste. 420, Topeka, Kansas 66620-0001. Telephone: 785-296-3565. Send one to Water Well Owner and retain one for your records.