

1	LOCATION OF WATER WELL: County: <i>Sodawick</i>	Fraction <i>SW</i> $\frac{1}{4}$ <i>SE</i> $\frac{1}{4}$ <i>SE</i> $\frac{1}{4}$	Section Number <i>25</i>	Township Number T <i>28</i> S	Range Number R <i>1E</i> E/W
---	--	---	-----------------------------	----------------------------------	---------------------------------

Distance and direction from nearest town or city street address of well if located within city?


2 WATER WELL OWNER:

RR#, St. Address, Box # : 217 Stone Path
City, State, ZIP Code : Derby, KS

Board of Agriculture, Division of Water Resources
Application Number:

3 LOCATE WELL'S LOCATION WITH AN "X" IN SECTION BOX:

4 DEPTH OF COMPLETED WELL 90 ft. ELEVATION:

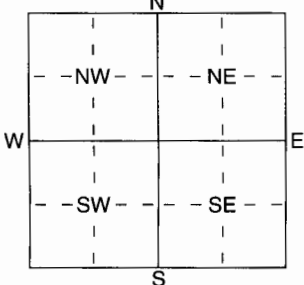

Depth(s) Groundwater Encountered 1 27 ft. 2 _____ ft. 3 _____ ft.
WELL'S STATIC WATER LEVEL 27 ft. below land surface measured on mo/day/yr 4/20/05
Pump test data: Well water was _____ ft. after _____ hours pumping _____ gpm
Est. Yield _____ gpm: Well water was _____ ft. after _____ hours pumping _____ gpm
WELL WATER TO BE USED AS:
1 Domestic 3 Feedlot 5 Public water supply 8 Air conditioning 11 Injection well
2 Irrigation 4 Industrial 6 Oil field water supply 9 Dewatering 12 Other (Specify below)
7 Domestic (lawn & garden) 10 Monitoring well

Was a chemical/bacteriological sample submitted to Department? Yes No X ; If yes, mo/day/yr sample was submitted
Water Well Disinfected? Yes X No

5	TYPE OF BLANK CASING USED:
---	----------------------------

- 1 Steel
2 PVC
3 RMP (SR)
4 ABS
5 Asbestos-Cement
6 Fiberglass
7 Other (specify below)
8 Welded
9 Threaded


TYPE OF SCREEN OR PERFORATION MATERIAL:

- 1 Steel 3 Stainless Steel 5 Fiberglass 8 RMP (SR) 11 Other (Specify)
- 2 Brass 4 Galvanized Steel 6 Concrete tile 9 ABS 12 None used (open hole)

~~SCREEN OR PERFORATION OPENINGS ARE:~~

- 1 Continuous slot 3 Mill slot 6 Wire wrapped 9 Drilled holes
2 Louvered shutter 4 Key punched 7 Torch cut 10 Other (specify) ft.

SCREEN-PERFORATED INTERVALS: From 50 ft. to 90 ft., From _____ ft. to _____ ft.

GRAVEL PACK INTERVALS:

From	ft. to	ft. From	ft. to
From 24	ft. to 90	ft. From	ft. to
From	ft. to	ft. From	ft. to

6	GROUT MATERIAL:
---	-----------------

- 6 GROUT MATERIAL: 1 Neat cement 2 Cement grout 3 Bentonite 4 Other.....

Grout Intervals: From 4 ft. to 24 ft., From 24 ft. to 30 ft., From 30 ft. to 36 ft.

What is the nearest source of possible contamination:

- | | | | | |
|--------------------------|-----------------|-----------------|------------------------|--------------------------|
| 1 Septic tank | 4 Lateral lines | 7 Pit privy | 11 Fuel storage | 15 Oil well/Gas well |
| 2 Sewer lines | 5 Cess pool | 8 Sewage lagoon | 12 Fertilizer storage | 16 Other (specify below) |
| 3 Watertight sewer lines | 6 Seepage pit | 9 Feedyard | 13 Insecticide storage | |

Direction from well? East How many feet? 20

[illegible]


Water Well Contractor's Licence No. 11-2413 This Water Well Record was completed on (mo/day/yr) 4/30/05
under the business name of Chase Drilling by (signature) R Chase