

1	LOCATION OF WATER WELL:	Fraction	Section Number	Township Number	Range Number
County:	Sedawick	NE $\frac{1}{4}$ NE $\frac{1}{4}$ NW $\frac{1}{4}$	22	T 28.5 S	R 1E E/W

Distance and direction from nearest town or city street address of well if located within city?


4835 S. Spruce

2 WATER WELL OWNER: G. F. Crisp
RR#, St. Address, Box # : 4835 S. Spruce
City, State, ZIP Code : Wichita, KS

Board of Agriculture, Division of Water Resources
Application Number:

3	LOCATE WELL'S LOCATION WITH	4	DEPTH OF COMPLETED WELL 30 ft. ELEVATION:
---	-----------------------------	---	---

AN "X" IN SECTION BOX:

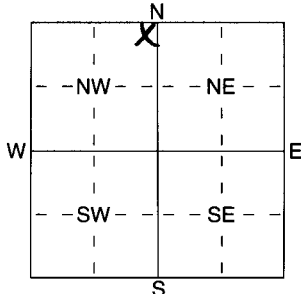

Depth(s) Groundwater Encountered 12 ft. 2 ft. 3 ft.
WELL'S STATIC WATER LEVEL 12 ft. below land surface measured on mo/day/yr
Pump test data: Well water was ft. after hours pumping gpm
Est. Yield gpm: Well water was ft. after hours pumping gpm
WELL WATER TO BE USED AS: 5 Public water supply 8 Air conditioning 11 Injection well
1 Domestic 3 Feedlot 6 Oil field water supply 9 Dewatering 12 Other (Specify below)
2 Irrigation 4 Industrial 7 Domestic (lawn & garden) 10 Monitoring well

Was a chemical/bacteriological sample submitted to Department? Yes No X ; If yes, mo/day/yr sample was submitted
Water Well Disinfected? Yes X No

5	TYPE OF BLANK CASING USED:
---	----------------------------

1 ~~Steel~~ 3 RMP (SR)
2 PVC 4 ABS

5 Wrought iron
6 Asbestos-Cement
7 Fiberglass

8 Concrete tile
9 Other (specify below)

CASING JOINTS: Glued X..... Clamped
Welded
Threaded

Blank casing diameter 5 in. to 30 ft., Dia in. to ft., Dia in. to ft.

Casing height above land surface 16 in., weight 1100 lbs./ft. Wall thickness or gauge No. 26

TYPE OF SCREEN OR PERFORATION MATERIAL:

1 Steel	3 Stainless Steel
2 Brass	4 Galvanized Steel

5 Fiberglass
6 Concrete tile

7 PVC
8 RMP (SR)
9 ABS

10 Asbestos-Cement
11 Other (Specify)
12 None used (open hole)

~~SCREEN OR PERFORATION OPENINGS ARE:~~

1 Continuous slot
2 Louvered shutter
3 Mill slot
4 Key punched

5 Guazed wrapped
6 Wire wrapped
7 Torch cut

8 Saw cut
9 Drilled holes
10 Other (specify)ft.
11 None (open hole)

SCREEN-PERFORATED INTERVALS: From 20 ft. to 30 ft., From _____ ft. to _____ ft.

From ft. to ft., From ft. to ft.

GRAVEL PACK INTERVALS: From 24 ft. to 30 ft., From _____ ft. to _____ ft.

From ft. to ft., From ft. to ft.

6	GROUT MATERIAL:	1 Neat cement
---	-----------------	---------------

Grout Intervals: From 4 ft. to 24 ft., From _____ ft. to _____ ft., From _____ ft. to _____ ft.

What is the nearest source of possible contamination:

1 Septic tank	4 Lateral lines
2 Sewer lines	5 Cess pool
3 Watertight sewer lines	6 Seepage pit

7 Pit privy
8 Sewage lagoon
9 Feedyard

10 Livestock pens	14 Abandoned water well
11 Fuel storage	15 Oil well/Gas well
12 Fertilizer storage	16 Other (specify below)
13 Insecticide storage	

Direction from well? *West*

How many feet? 50

[illegible]

7 CONTRACTOR'S OR LANDOWNER'S CERTIFICATION: This water well was (1) constructed, (2) reconstructed, or (3) plugged under my jurisdiction and was completed on (mo/day/year) 10/17/02 and this record is true to the best of my knowledge and belief. Kansas

Water Well Contractor's Licence No. 6611 This Water Well Record was completed on (mo/day/yr) 5-23-05
under the business name of Chase Drilling by (signature) [Signature]