


1	LOCATION OF WATER WELL:	Fraction	Section Number	Township Number	Range Number
County:	Sedgewick	SE $\frac{1}{4}$ SW $\frac{1}{4}$ SW $\frac{1}{4}$	29	T 28 S	R 1 EW

Distance and direction from nearest town or city street address of well if located within city?
902 W 63rd St. S. Wichita

2] WATER WELL OWNER: LAURA NELSON
RR#, St. Address, Box # : 128 OLD STILLHOUSE Hollow
City, State, ZIP Code : CRANE MO 65633 PLUGGED

Board of Agriculture, Division of Water Resources
Application Number: 1

3	LOCATE WELL'S LOCATION WITH	4	DEPTH OF COMPLETED WELL 30' ft. ELEVATION: Existing Ground
---	-----------------------------	---	--

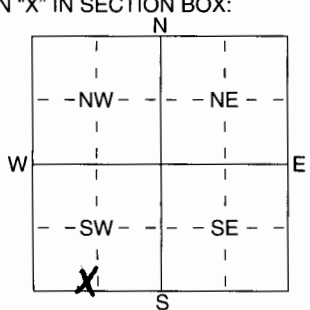

Depth(s) Groundwater Encountered 1 ft. 2 ft. 3 ft. 4 ft.

WELL'S STATIC WATER LEVEL 12 ft. below land surface measured on mo/day/yr. 3-11-06

Pump test data: Well water was _____ ft. after _____ hours pumping _____ gpm

Est. Yield WAS gpm Well water was _____ ft. after _____ hours pumping _____ gpm

WELL WATER WAS USED AS:

5 Public water supply	8 Air conditioning	11 Injection well		
1 Domestic	3 Feedlot	6 Oil field water supply	9 Dewatering	12 Other (Specify below)
2 Irrigation	4 Industrial	7 Domestic (lawn & garden)	10 Monitoring well	

Was a chemical/bacteriological sample submitted to Department? Yes No X ; If yes, mo/day/yr sample was submitted
Water Well Disinfected? Yes X No

5	TYPE OF BLANK CASING USED:		5 Wrought iron	8 Concrete tile	CASING JOINTS: Glued Clamped Welded Threaded
	1 Steel	3 RMP (SR)	6 Asbestos-Cement	9 Other (specify below)	
	2 PVC	4 ABS	7 Fiberglass		

Blank casing diameter in. to ft., Dia in. to ft., Dia in. to ft.
Casing height above land surface 30' in., weight lbs./ft. Wall thickness or gauge No.

TYPE OF SCREEN OR PERFORATION MATERIAL:			7 PVC	10 Asbestos-Cement
1 Steel	3 Stainless Steel	5 Fiberglass	8 RMP (SR)	11 Other (Specify) <i>N/A</i>
2 Brass	4 Galvanized Steel	6 Concrete tile	9 ABS	12 None used (open hole)

SCREEN OR PERFORATION OPENINGS ARE:

1 Continuous slot	3 Mill slot	5 Guazed wrapped	8 Saw cut	11 None (open hole)
2 Louvered shutter	4 Key punched	6 Wire wrapped	9 Drilled holes	
		7 Torch cut	10 Other (specify) <i>N/A</i>	ft.

SCREEN-PERFORATED INTERVALS:	From ft. to ft.,	From ft. to ft.
	From ft. to ft.,	From ft. to ft.
GRAVEL PACK INTERVALS:	From ft. to ft.,	From ft. to ft.
	From ft. to ft.,	From ft. to ft.

6 GROUT MATERIAL: 1 Neat cement 2 Cement grout 3 Bentonite 4 Other
Grout Intervals: From 0 ft. to 30 ft., From ft. to ft., From ft. to ft.

What is the nearest source of possible contamination:

1 Septic tank	4 Lateral lines	7 Pit privy	10 Livestock pens	14 Abandoned water well
2 Sewer lines	5 Cess pool	8 Sewage lagoon	11 Fuel storage	15 Oil well/Gas well
3 Watertight sewer lines	6 Seepage pit	9 Feedyard	12 Fertilizer storage	16 Other (specify below)
Direction from well?	North		13 Insecticide storage	
			How many feet?	35

[illegible]

7] CONTRACTOR'S OR LANDOWNER'S CERTIFICATION: This water well was (1) constructed, (2) reconstructed, or (3) plugged under my jurisdiction and was completed on (mo/day/year) 3-11-06 and this record is true to the best of my knowledge and belief. Kansas Water Well Contractor's Licence No. _____ This Water Well Record was completed on (mo/day/yr) 3-11-06 under the business name of INDIVIDUAL by (signature) Wille Skiff