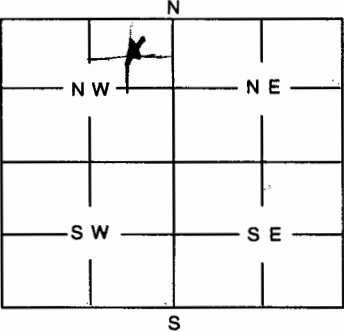


1	LOCATION OF WATER WELL: County: <u>Sedgwick</u>	Fraction <u>NE 1/4 NE 1/4 NW 1/4</u>	Section Number <u>8</u>	Township Number <u>28S</u>	Range Number <u>1E</u>																					
Distance and direction from nearest town or city street address of well if located within city?																										
2	WATER WELL OWNER: <u>Aundria Criswell</u> RR #, St. Address, Box #: <u>3250 S. Silver</u> City, State, ZIP Code: <u>Wichita, KS 67217</u> Board of Agriculture, Division of Water Resources Application Number:																									
3	MARK WELL'S LOCATION WITH AN "X" IN SECTION BOX: 																									
4	DEPTH OF WELL <u>27</u> ft WELL'S STATIC WATER LEVEL <u>21</u> ft. WELL WAS USED AS: <table style="width:100%;"> <tr> <td>1 Domestic</td> <td>5 Public Water Supply</td> <td>9 Dewatering</td> </tr> <tr> <td>2 Irrigation</td> <td>6 Oil Field Water Supply</td> <td>10 Monitoring Well</td> </tr> <tr> <td>3 Feedlot</td> <td>7 <u>Domestic (Lawn & Garden)</u></td> <td>11 Injection Well</td> </tr> <tr> <td>4 Industrial</td> <td>8 Air Conditioning</td> <td>12 Other</td> </tr> </table> Was a chemical / bacteriological sample submitted to Department? Yes No If yes, mo/day/yr sample was submitted Water Well Disinfected: Yes No					1 Domestic	5 Public Water Supply	9 Dewatering	2 Irrigation	6 Oil Field Water Supply	10 Monitoring Well	3 Feedlot	7 <u>Domestic (Lawn & Garden)</u>	11 Injection Well	4 Industrial	8 Air Conditioning	12 Other									
1 Domestic	5 Public Water Supply	9 Dewatering																								
2 Irrigation	6 Oil Field Water Supply	10 Monitoring Well																								
3 Feedlot	7 <u>Domestic (Lawn & Garden)</u>	11 Injection Well																								
4 Industrial	8 Air Conditioning	12 Other																								
5	TYPE OF BLANK CASING USED: 1 Steel 3 RMP (SR) 5 Wrought 7 Fiberglass 9 Other (Specify below), 2 PVC 4 ABS 6 Asbestos-Cement 8 Concrete Tile Blank casing diameter <u>1 1/4</u> in. Was casing pulled? Yes No Casing height above or below land surface <u>cut level w/ground</u> If yes, how much																									
6	GROUT PLUG MATERIAL: 1 Neat cement 2 Cement grout 3 Bentonite 4 Other Grout Plug Intervals: From ft. to ft., From ft. to ft., From ft. to ft. What is the nearest source of possible contamination: <table style="width:100%;"> <tr> <td>1 Septic tank</td> <td>6 Seepage pit</td> <td>11 Fuel storage</td> <td>16 Other (specify below)</td> </tr> <tr> <td>2 Sewer lines</td> <td>7 Pit privy</td> <td>12 Fertilizer storage</td> <td></td> </tr> <tr> <td>3 Watertight sewer lines</td> <td>8 Sewage lagoon</td> <td>13 Insecticide storage</td> <td></td> </tr> <tr> <td>4 Lateral lines</td> <td>9 Feedyard</td> <td>14 Abandoned water well</td> <td></td> </tr> <tr> <td>5 Cess Pool</td> <td>10 Livestock pens</td> <td>15 Oil well/Gas well</td> <td></td> </tr> </table> Direction from well? How many feet?					1 Septic tank	6 Seepage pit	11 Fuel storage	16 Other (specify below)	2 Sewer lines	7 Pit privy	12 Fertilizer storage		3 Watertight sewer lines	8 Sewage lagoon	13 Insecticide storage		4 Lateral lines	9 Feedyard	14 Abandoned water well		5 Cess Pool	10 Livestock pens	15 Oil well/Gas well		
1 Septic tank	6 Seepage pit	11 Fuel storage	16 Other (specify below)																							
2 Sewer lines	7 Pit privy	12 Fertilizer storage																								
3 Watertight sewer lines	8 Sewage lagoon	13 Insecticide storage																								
4 Lateral lines	9 Feedyard	14 Abandoned water well																								
5 Cess Pool	10 Livestock pens	15 Oil well/Gas well																								
<table border="1" style="width:100%; border-collapse: collapse;"> <thead> <tr> <th style="width:10%;">FROM</th> <th style="width:10%;">TO</th> <th style="width:80%;">PLUGGING MATERIALS</th> </tr> </thead> <tbody> <tr> <td>0</td> <td>27</td> <td>Top to bottom w/ bentonite</td> </tr> <tr><td> </td><td> </td><td> </td></tr> <tr><td> </td><td> </td><td> </td></tr> <tr><td> </td><td> </td><td> </td></tr> <tr><td> </td><td> </td><td> </td></tr> <tr><td> </td><td> </td><td> </td></tr> </tbody> </table>						FROM	TO	PLUGGING MATERIALS	0	27	Top to bottom w/ bentonite															
FROM	TO	PLUGGING MATERIALS																								
0	27	Top to bottom w/ bentonite																								
7	CONTRACTOR'S OR LANDOWNER'S CERTIFICATION: This water well was plugged under my jurisdiction and was completed on (mo/day/year) <u>10/26/06</u> and this record is true to the best of my knowledge and belief. Kansas Water Well Contractor's License No. <u>6411</u> This Water Well Record was completed on (mo/day/year) <u>10/27/06</u> under the business name of <u>Chase Drilling</u> by (signature) <u>D Chase</u>																									
INSTRUCTIONS: Use typewriter or ball point pen. Please press firmly and print clearly. Please fill in blanks, underline or circle the correct answers. Send top three copies to Kansas Department of Health and Environment, Bureau of Water, Topeka, Kansas 66620-0001. Telephone: 785/296-3565. Send one to Water Well Owner and retain one for your records.																										