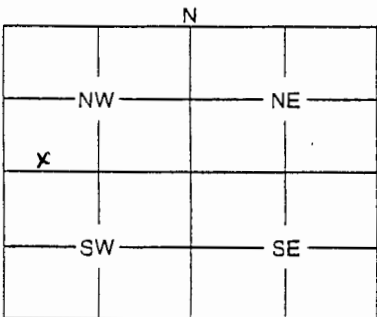


1	LOCATION OF WATER WELL:	Fraction	Section	Number	Township	Number	Range	Number
	County: <u>Sedgwick</u>	<u>NW 1/4 SW 1/4 SW 1/4 SE</u>	<u>8</u>		<u>28</u>		<u>1</u>	<u>5</u> (EAW)

Distance and direction from nearest town or city street address of well if located within city?

3838 S. Gold Street

2	WATER WELL OWNER: <u>Consolidated Fleetways</u>	RR #, St. Address, Box #: <u>3838 S. Gold Street</u>	Board of Agriculture, Division of Water Resources
	City, State, ZIP Code: <u>Wichita, KS</u>	Application Number:	

3	MARK WELL'S LOCATION WITH AN "X" IN SECTION BOX:	4	DEPTH OF WELL <u>17</u> ft.	MW5
		WELL'S STATIC WATER LEVEL <u>N/A</u> ft.		
		WELL WAS USED AS:		

- | | | |
|--------------|----------------------------|--------------------|
| 1 Domestic | 5 Public Water Supply | 9 Dewatering |
| 2 Irrigation | 6 Oil Field Water Supply | 10 Monitoring Well |
| 3 Feedlot | 7 Domestic (Lawn & Garden) | 11 Injection Well |
| 4 Industrial | 8 Air Conditioning | 12 Other |

Was a chemical / bacteriological sample submitted to Department? Yes No X.....
 If yes, mo/day/yr sample was submitted

Water Well Disinfected: Yes No X.....

5	TYPE OF BLANK CASING USED:
	1 Steel 3 RMP (SR) 5 Wrought 7 Fiberglass 9 Other (Specify below) <u>2 PVC</u> 4 ABS 6 Asbestos-Cement 8 Concrete Tile
	Blank casing diameter <u>2</u> in. Was casing pulled? Yes <u>X</u> No If yes, how much <u>ALL</u>
	Casing height above <u>below</u> land surface <u>3</u> in.

6	GROUT PLUG MATERIAL:	1 Neat cement	2 Cement grout	<u>3 Bentonite</u>	4 Other
	Grout Plug Intervals:	From <u>3</u> ft.	to <u>17</u> ft.	From ft.	to ft.
	What is the nearest source of possible contamination:				
	1 Septic tank 2 Sewer lines 3 Watertight sewer lines 4 Lateral lines 5 Cess pool	6 Seepage pit 7 Pit privy 8 Sewage lagoon 9 Feedyard 10 Livestock pens	11 Fuel storage 12 Fertilizer storage 13 Insecticide storage 14 Abandoned water well 15 Oil well/Gas well	<u>16 Other (specify below)</u> <u>LEAST</u>	
	Direction from well? <u>NE</u>		How many feet? <u>15</u>		

FROM	TO	PLUGGING MATERIALS
<u>0</u>	<u>1</u>	<u>Concrette</u>
<u>1</u>	<u>3</u>	<u>Sail</u>
<u>3</u>	<u>17</u>	<u>Bentonite</u>

7	CONTRACTOR'S OF LANDOWNER'S CERTIFICATION: This water well was plugged under my jurisdiction and was completed on (mo/day/year) <u>11/17/06</u> and this record is true to the best of my knowledge and belief. Kansas Water Well Contractor's License No. <u>757</u> This Water Well Record was completed on (mo/day/year) <u>12/13/06</u> under the business name of <u>Lansan Industries</u> by (signature) <u>[Signature]</u>
---	---

INSTRUCTIONS: Use typewriter or ball point pen. Please press firmly and print clearly. Please fill in blanks, underline or circle the correct answers. Send top three copies to Kansas Department of Health and Environment, Bureau of Water, Geology Section, 1000 SW Jackson St., Ste. 420, Topeka, Kansas 66612-1367. Telephone: 785/296-5522. Send one to Water Well Owner and retain one for your records.