WATER WELL PLUGGING RECORD Form WWC-5P KSA 82a-1 212 ID NO

1 LOCATION OF WATER WELL:	Fraction	Section Number	Township Number	Range Number
County: Sedgwick	NE 1/4 NE 1/4 1/4	20	28	1 ~~W~~ EAST

Distance and direction from nearest town or city street address of well if located within city?
46th Street South and South Broadway, Wichita, KS

2 WATER WELL OWNER: Broadway 47th LLC
RR #, St. Address, Box # 9400 Reeds Rd., Suite 100
City, State, ZIP Code Overland Park, KS 66207

Board of Agriculture, Division of Water Resources
Application Number:

3 **MARK** WELL'S LOCATION WITH AN "X" IN SECTION BOX:

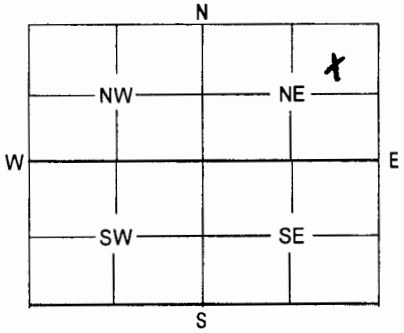

4 DEPTH OF WELL 20 ft.

WELL'S STATIC WATER LEVEL 999 ft.

WELL WAS USED AS:

1 Domestic 5 Public Water Supply 9 Dewatering
2 Irrigation 6 Oil Field Water Supply 10 Monitoring Well
3 Feedlot 7 Domestic (Lawn & Garden) 11 Injection Well
4 Industrial 8 Air Conditioning (12) Other Remediation

Was a chemical / bacteriological sample submitted to Department? Yes ..... No X
if yes, mo/day/yr sample was submitted .....

Water Well Disinfected: Yes ..... No X

5 TYPE OF BLANK CASING USED:

1 Steel 3 RMP (SR) 5 Wrought 7 Fiberglass 9 Other (Specify below)
(2) PVC 4 ABS 6 Asbestos-Cement 8 Concrete Tile

Blank casing diameter 4 in. Was casing pulled? Yes X No ..... If yes, how much All
Casing height above or below land surface 0 in.

6 GROUT PLUG MATERIAL: 1 Neat cement 2 Cement grout (3) Bentonite 4 Other .....

Grout Plug Intervals: From 20 ft. to 0 ft., From ..... ft. to ..... ft., From ..... to ..... ft

What is the nearest source of possible contamination:

1 Septic tank 6 Seepage pit 11 Fuel storage 16 Other (specify below)
2 Sewer lines 7 Pit privy 12 Fertilizer storage
3 Watertight sewer lines 8 Sewage lagoon 13 Insecticide storage
4 Lateral lines 9 Feedyard 14 Abandoned water well
5 Cess pool 1 0 Livestock pens 15 Oil well/Gas well

Direction from well? 999 How many feet? 999

FROM	TO	PLUGGING MATERIALS
20	0	3/8 Bentonite chips
		Plug well 2

7 CONTRACTOR'S OF LANDOWNER'S CERTIFICATION: This water well was plugged under my jurisdiction and was completed on (mo/day/year) 8-10-07 and this record is true to the best of my knowledge and belief. Kansas Water Well Contractor's License No. 665 This Water Well Record was completed on (mo/day/year) 8-27-07 under the business name of Pratt Well Environmental

by (signature) Glenn E. Eyell

INSTRUCTIONS: Use typewriter or ball point pen. Please press firmly and print clearly. Please fill in blanks, underline or circle the correct answers. Send top three copies to Kansas Department of Health and Environment, Bureau of Water, Geology Section, 1 000 SW Jackson St., Ste. 420, Topeka, Kansas 66612-1367. Telephone: 785/296-5522. Send one to Water Well Owner and retain one for your records.