

WATER WELL RECORD Form WWC-5 KSA 82a-1212 ID No.

1 LOCATION OF WATER WELL:	Fraction	Section Number	Township Number	Range Number
County: Sedgwick	NE ¼ SW ¼ SW ¼	12	T 28 S	R 1 E

Distance and direction from nearest town or city street address of well if located within city?

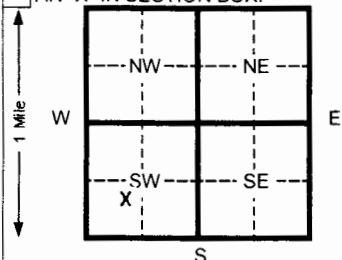
88' S, 25' W of Light Pole 406->, Boeing, Wichita2 WATER WELL OWNER: **Boeing Company**RR#, St. Address, Box #: **2727 E. MacArthur**

Board of Agriculture, Division of Water Resources

City, State, ZIP Code: **Wichita, KS 67217**

Application Number:

3 LOCATE WELL'S LOCATION WITH AN "X" IN SECTION BOX:

4 DEPTH OF COMPLETED WELL **49** ft. ELEVATION: **1351.24 (TOC)**

Depth(s) Groundwater Encountered 1 _____ ft. 2 _____ ft. 3 _____ ft.

WELL'S STATIC WATER LEVEL **9.0** Ft. below land surface measured on **10/22/07**
mo/day/yr

Pump test data: Well water was _____ ft. after _____ hours pumping _____ gpm

Est. Yield _____ gpm: Well water was _____ ft. after _____ hours pumping _____ gpm

Bore Hole Diameter **8** in. to **50** ft. and _____ in. to _____ ft.

WELL WATER TO BE USED AS: 5 Public water supply 8 Air conditioning 11 Injection well

1 Domestic 3 Feed lot 6 Oil field water supply 9 Dewatering 12 Other (Specify below)

2 Irrigation 4 Industrial 7 Lawn and garden (domestic) **10 Monitoring well**Was a chemical/bacteriological sample submitted to Department? Yes _____ No **X** If yes, mo/day/yr sample wassubmitted Water Well Disinfected? Yes _____ No **X**

5 TYPE OF BLANK CASING USED:

1 Steel 3 RMP (SR)

5 Wrought Iron

8 Concrete tile

CASING JOINTS: Glued _____ Clamped _____

2 PVC 4 ABS

6 Asbestos-Cement 9 Other (specify below) _____

7 Fiberglass

Threaded FlushBlank casing diameter **2** in. to **29** ft. Dia _____ in. to _____ ft. Dia _____ in. to _____ ft.Casing height above land surface **Flushmount** in., weight **0.703** lbs./ft. Wall thickness or gauge No. **SCH. 40**

TYPE OF SCREEN OR PERFORATION MATERIAL:

1 Steel 3 Stainless steel

5 Fiberglass

7 PVC 10 Asbestos-cement

2 Brass 4 Galvanized steel

6 Concrete tile

8 RMP (SR)

11 Other (specify) _____

SCREEN OR PERFORATION OPENINGS ARE:

1 Continuous slot **3 Mill slot**

5 Gauzed wrapped

8 Saw cut

11 None (open hole)

2 Louvered shutter 4 Key punched

6 Wire wrapped

9 Drilled holes

10 Other (specify) _____

SCREEN-PERFORATED INTERVALS: From **29** ft. to **49** ft. From _____ ft. to _____ ft.

From _____ ft. to _____ ft. From _____ ft. to _____ ft.

GRAVEL PACK INTERVALS: From **27** ft. to **50** ft. From _____ ft. to _____ ft.

From _____ ft. to _____ ft. From _____ ft. to _____ ft.

6 GROUT MATERIAL:

1 Neat cement

2 Cement grout

3 Bentonite

4 Other _____

Grout Intervals From **1** ft. to **27** ft. From _____ ft. to _____ ft. From _____ ft. to _____ ft.

What is the nearest source of possible contamination:

1 Septic tank 4 Lateral lines

7 Pit privy

10 Livestock pens

14 Abandoned water well

2 Sewer lines 5 Cess pool

8 Sewage lagoon

11 Fuel storage

15 Oil well/ Gas well

3 Watertight sewer lines 6 Seepage pit

9 Feedyard

12 Fertilizer storage

16 Other (specify below) _____

Direction from well?

How many feet?

FROM	TO	CODE	LITHOLOGIC LOG	FROM	TO	PLUGGING INTERVALS
0	1.5		Concrete			
1.5	12.5		Clay, red brown, some silt			
12.5	27		Silty Clay, light brown, with caliche nodules			
27	28.5		Sandy Clay, light brown			
28.5	39.5		Silty Clay, light gray to light red brown, with some caliche nodules and sand			
39.5	41.5		Sandy Clay, blue gray			
41.5	41.7		Sand, fine grains			
41.7	50		Shale, olive			

7 CONTRACTOR'S OR LANDOWNER'S CERTIFICATION: This water well was **(1) constructed**, (2) reconstructed, or (3) plugged under my jurisdiction and wascompleted on (mo/day/yr) **10/31/07** and this record is true to the best of my knowledge and belief. KansasWater Well Contractor's License No. **531** This Water Well Record was completed on (mo/day/yr) **11/08/07**under the business name of **Geotechnical Services Inc.** by (signature) *Donah & Wate*

INSTRUCTIONS: Please fill in blanks and circle the correct answers. Send three copies to Kansas Department of Health and Environment, Bureau of Water, 1000 S W Jackson St., Ste. 420, Topeka, Kansas 66612-1367. Telephone: 913-296-5545. Send one to WATER WELL OWNER and retain one for your records.