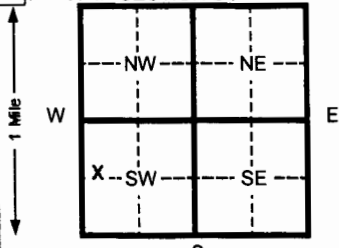
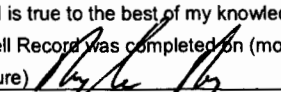


WATER WELL RECORD Form WWC-5 KSA 82a-1212 ID No.

1 LOCATION OF WATER WELL:		Fraction		Section Number		Township Number		Range Number	
County: Sedgwick		SW ¼ NW ¼ SW ¼		21		T 28 S		R 1 E	
Distance and direction from nearest town or city street address of well if located within city? 5330 S. Broadway - Wichita									
2 WATER WELL OWNER: Fuel Managers, Inc.									
RR#, St. Address, Box # : 10711 E. 11th St. Board of Agriculture, Division of Water Resources									
City, State, ZIP Code : Tulsa, OK 74128 Application Number:									
3 LOCATE WELL'S LOCATION WITH AN "X" IN SECTION BOX:		4 DEPTH OF COMPLETED WELL 20 ft. ELEVATION: 1272.48 (TOC)							
		Depth(s) Groundwater Encountered 1 14 ft. 2 _____ ft. 3 _____ ft.							
		WELL'S STATIC WATER LEVEL _____ ft. below land surface measured on mo/day/yr							
		Pump test data: Well water was _____ ft. after _____ hours pumping _____ gpm							
		Est. Yield _____ gpm: Well water was _____ ft. after _____ hours pumping _____ gpm							
		Bore Hole Diameter 8.25 in. to 20 ft. and _____ in. to _____ ft.							
		WELL WATER TO BE USED AS: 5 Public water supply 8 Air conditioning 11 Injection well							
		1 Domestic 3 Feed lot 6 Oil field water supply 9 Dewatering 12 Other (Specify below)							
		2 Irrigation 4 Industrial 7 Lawn and garden (domestic) 10 Monitoring well							
		Was a chemical/bacteriological sample submitted to Department? Yes _____ No X If yes, mo/day/yr sample was submitted							
		Water Well Disinfected? Yes _____ No X							
5 TYPE OF BLANK CASING USED:									
1 Steel 3 RMP (SR) 5 Wrought Iron 8 Concrete tile CASING JOINTS: Glued _____ Clamped _____									
2 PVC 4 ABS 6 Asbestos-Cement 9 Other (specify below) Welded _____									
3 Fiberglass _____ Threaded _____ Flush _____									
Blank casing diameter 2 in. to 10 ft., Dia _____ in. to _____ ft., Dia _____ in. to _____ ft.									
Casing height above land surface Flushmount in., weight 0.703 lbs./ft. Wall thickness or gauge No. SCH. 40									
TYPE OF SCREEN OR PERFORATION MATERIAL:									
1 Steel 3 Stainless steel 5 Fiberglass 7 PVC 10 Asbestos-cement									
2 Brass 4 Galvanized steel 6 Concrete tile 8 RMP (SR) 11 Other (specify) _____									
SCREEN OR PERFORATION OPENINGS ARE:									
1 Continuous slot 3 Mill slot 5 Gauzed wrapped 8 Saw cut 11 None (open hole)									
2 Louvered shutter 4 Key punched 6 Wire wrapped 9 Drilled holes									
7 Torch cut 10 Other (specify) _____									
SCREEN-PERFORATED INTERVALS: From 10 ft. to 20 ft. From _____ ft. to _____ ft.									
From _____ ft. to _____ ft. From _____ ft. to _____ ft.									
GRAVEL PACK INTERVALS: From 8 ft. to 20 ft. From _____ ft. to _____ ft.									
From _____ ft. to _____ ft. From _____ ft. to _____ ft.									
6 GROUT MATERIAL: 1 Neat cement 2 Cement grout 3 Bentonite 4 Other _____									
Grout Intervals From 1 ft. to 8 ft. From _____ ft. to _____ ft. From _____ ft. to _____ ft.									
What is the nearest source of possible contamination:									
1 Septic tank 4 Lateral lines 7 Pit privy 10 Livestock pens 14 Abandoned water well									
2 Sewer lines 5 Cess pool 8 Sewage lagoon 11 Fuel storage 15 Oil well/ Gas well									
3 Watertight sewer lines 6 Seepage pit 9 Feedyard 12 Fertilizer storage 16 Other (specify below) _____									
13 Insecticide storage _____									
Direction from well? _____ How many feet? _____									
FROM TO CODE LITHOLOGIC LOG FROM TO PLUGGING INTERVALS									
0 1 Pavement									
1 5 Topsoil/Silt and Sand, dark brown to orange brown									
5 7 Sand, fine to coarse grained									
7 10.5 Clay, brown with orange mottling, some silt and sand									
10.5 14 Silt and Sand, brown with orange mottling									
14 20 Sand, fine to coarse grained, with pebbles									
7 CONTRACTOR'S OR LANDOWNER'S CERTIFICATION: This water well was (1) constructed , (2) reconstructed, or (3) plugged under my jurisdiction and was completed on (mo/day/yr) 05/20/08 and this record is true to the best of my knowledge and belief. Kansas									
Water Well Contractor's License No. 531 This Water Well Record was completed on (mo/day/yr) 06/12/08									
under the business name of Geotechnical Services Inc. by (signature) 									
INSTRUCTIONS: Please fill in blanks and circle the correct answers. Send three copies to Kansas Department of Health and Environment, Bureau of Water, 1000 S W Jackson St., Ste. 420, Topeka, Kansas 66612-1367. Telephone: 913-296-5545. Send one to WATER WELL OWNER and retain one for your records.									