

WATER WELL RECORD MW-3 Form WWC-5

Division of Water Resources; App. No.

EAST

1 LOCATION OF WATER WELL: County: <u>Sedgwick</u>		Fraction <u>NE 1/4 SE 1/4 SE 1/4</u>	Section Number <u>7</u>	Township Number <u>T 28 S</u>	Range Number <u>R 1 E</u>
Distance and direction from nearest town or city street address of well if located within city? <u>See map</u>			Global Positioning Systems (decimal degrees, min. of 4 digits) Latitude: <u>N 37° 37' 32.1"</u> Longitude: <u>W 97° 21' 10.8"</u> Elevation: _____ Datum: _____ Data Collection Method: <u>Garmin Nuvi</u>		
2 WATER WELL OWNER: <u>TPI Station No. 2175</u> RR#, St. Address, Box # : <u>3801 South Seneca</u> City, State, ZIP Code : <u>Wichita, KS</u>					

3 LOCATE WELL'S LOCATION WITH AN "X" IN SECTION BOX: 	4 DEPTH OF COMPLETED WELL <u>15</u> ft.	
	Depth(s) Groundwater Encountered (1)..... ft. (2)..... ft. (3)..... ft. WELL'S STATIC WATER LEVEL... <u>9.54</u> ft. below land surface measured on mo/day/yr..... Pump test data: Well water was.....ft. after..... hours pumping..... gpm Est. Yield.....gpm: Well water was.....ft. after..... hours pumping..... gpm WELL WATER TO BE USED AS: 5 Public water supply 8 Air conditioning 11 Injection well 1 Domestic 3 Feedlot 6 Oil field water supply 9 Dewatering 12 Other (Specify below) 2 Irrigation 4 Industrial 7 Domestic (lawn & garden) <u>10 Monitoring well</u> Was a chemical/bacteriological sample submitted to Department? Yes No <u>X</u> If yes, mo/day/yr Sample was submitted..... <u>N/A</u> Water well disinfected? Yes No <u>X</u>	

5 TYPE OF CASING USED:		5 Wrought Iron	8 Concrete tile	CASING JOINTS: Glued..... Clamped.....	
1 Steel	3 RMP (SR)	6 Asbestos-Cement	9 Other (specify below)	Welded.....	
<u>2 PVC</u>	4 ABS	7 Fiberglass		<u>Threaded</u>	
Blank casing diameter in. to <u>5</u> ft., Diameter..... in. to ft., Diameter..... in. to ft.					
Casing height above land surface..... <u>0</u> in., Weight <u>sch 40</u> lbs./ft. Wall thickness or gauge No.					
TYPE OF SCREEN OR PERFORATION MATERIAL:					
1 Steel	3 Stainless Steel	5 Fiberglass	<u>7 PVC</u>	9 ABS	11 Other (Specify)
2 Brass	4 Galvanized Steel	6 Concrete tile	8 RM (SR)	10 Asbestos-Cement	12 None used (open hole)
SCREEN OR PERFORATION OPENINGS ARE:					
1 Continuous slot	<u>3 Mill slot</u>	5 Gauzed wrapped	7 Torch cut	9 Drilled holes	11 None (open hole)
2 Louvered shutter	4 Key punched	6 Wire wrapped	8 Saw cut	10 Other (specify)	
SCREEN-PERFORATED INTERVALS: From..... <u>5</u> ft. to <u>15</u> ft., From..... ft. to ft., From..... ft. to ft.					
GRAVEL PACK INTERVALS: From..... <u>3</u> ft. to <u>15</u> ft., From..... ft. to ft., From..... ft. to ft.					

6 GROUT MATERIAL:		1 Neat cement	2 Cement grout	<u>3 Bentonite</u>	4 Other
Grout Intervals: From..... <u>2</u> ft. to <u>1.5</u> ft., From..... ft. to ft., From..... ft. to ft.					
What is the nearest source of possible contamination:					
1 Septic tank	4 Lateral lines	7 Pit privy	<u>10 Livestock pens</u>	13 Insecticide storage	16 Other (specify below)
2 Sewer lines	5 Cess pool	8 Sewage lagoon	<u>11 Fuel storage</u>	14 Abandoned water well	
3 Watertight sewer lines	6 Seepage pit	9 Feedyard	12 Fertilizer storage	15 Oil well/gas well	
Direction from well?		How many feet?			

FROM	TO	LITHOLOGIC LOG	FROM	TO	PLUGGING INTERVALS
			<u>0</u>	<u>6"</u>	<u>Concrete</u>
			<u>6"</u>	<u>2'</u>	<u>Top soil</u>
			<u>2'</u>	<u>15'</u>	<u>Bentonite</u>

7 CONTRACTOR'S OR LANDOWNER'S CERTIFICATION: This water well was (1) constructed, (2) reconstructed, or (3) plugged under my jurisdiction and was completed on (mo/day/year) 8-14-08 and this record is true to the best of my knowledge and belief. Kansas Water Well Contractor's License No. 759. This Water Well Record was completed on (mo/day/year) 8-23-08 under the business name of BAZEK Environmental, LLC by (signature) David J. Paul

INSTRUCTIONS: Use typewriter or ball point pen. PLEASE PRESS FIRMLY and PRINT clearly. Please fill in blanks, underline or circle the correct answers. Send top three copies to Kansas Department of Health and Environment, Bureau of Water, Geology Section, 1000 SW Jackson St., Suite 420, Topeka, Kansas 66612-1367. Telephone 785-296-5522. Send one to WATER WELL OWNER and retain one for your records. Fee of \$5.00 for each constructed well. Visit us at <http://www.kdheks.gov/waterwell/index.html>.

LEGEND:



MW-01 MONITORING WELL
 <1.0 Well Identification
 Benzene Concentration in
 micrograms per liter (ug/l)

A & D MOBILE HOMES

CAREY LANE

PUBLIC STORAGE

SENECA STREET

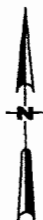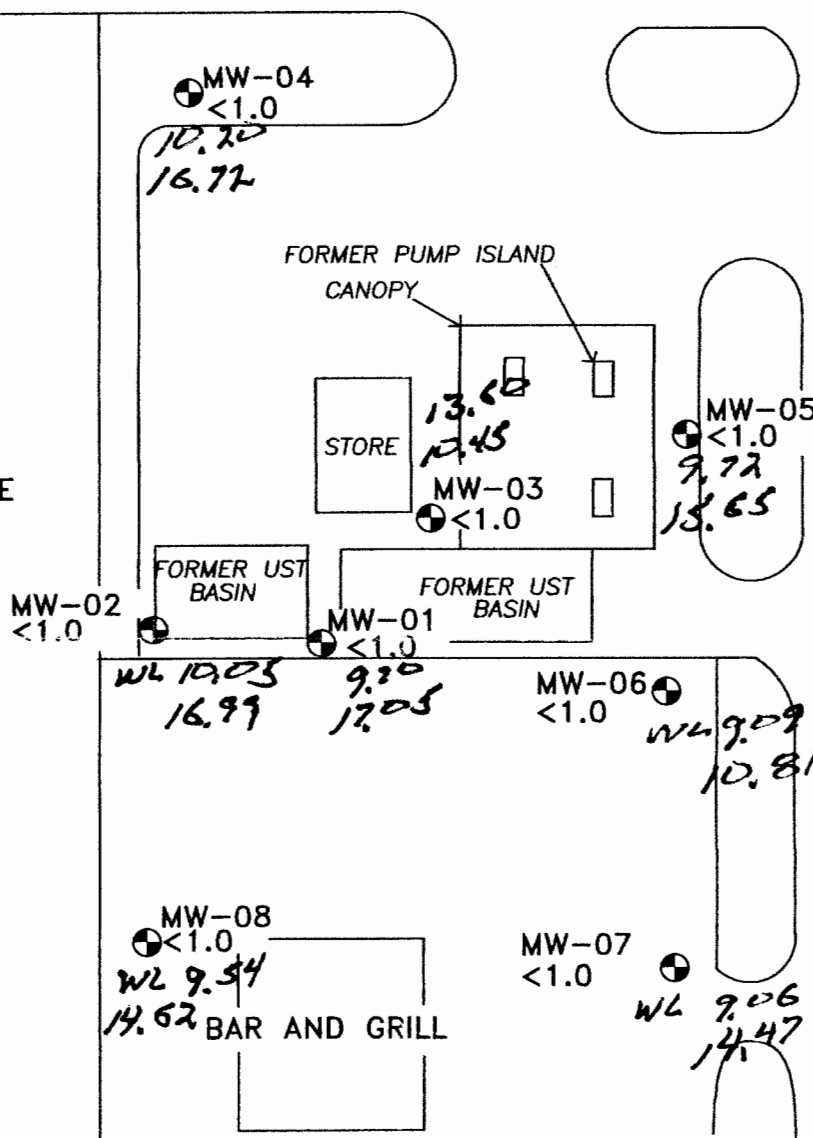

0 30 60 120
 APPROXIMATE SCALE (FEET)

**BENZENE ISOCONTOUR MAP
 (JANUARY 2, 2008)**

TPI STATION NO. 2175
 3801 SOUTH SENECA
 WICHITA, KANSAS

FIGURE
 2

PROJECT NUMBER:
 17.75250.2175

CHECKED BY:

JLA 01/16/08

DRAWING FILE: FIG4.DWG

DRAWN BY:
 JLA 04/06/07

VATC ASSOCIATES INC.