

EAST

1 LOCATION OF WATER WELL: County: <u>Sedgewick</u> Fraction: <u>NE 1/4 SE 1/4 SE 1/4</u> Section Number: <u>7</u> Township Number: <u>T 280S</u> Range Number: <u>R 1E</u>		Global Positioning Systems (decimal degrees, min. of 4 digits) Latitude: <u>N 37° 37' 32.1"</u> Longitude: <u>W 97° 21' 10.8"</u> Elevation: _____ Datum: _____ Data Collection Method: <u>Garmin Nv</u>	
2 WATER WELL OWNER: <u>TPI Station NO. 2115</u> RR#, St. Address, Box #: <u>3801 South Seneca</u> City, State, ZIP Code: <u>Wichita, KS</u>	
3 LOCATE WELL'S LOCATION WITH AN "X" IN SECTION BOX: N W E S <table border="1"><tr><td>-- NW --</td><td>-- NE --</td></tr><tr><td>-- SW --</td><td>-- SE --</td></tr></table>	-- NW --	-- NE --	-- SW --	-- SE --	4 DEPTH OF COMPLETED WELL <u>17.5</u> ft. Depth(s) Groundwater Encountered (1)..... <u>9.20</u> ft. (2)..... ft. (3)..... ft. WELL'S STATIC WATER LEVEL..... ft. below land surface measured on mo/day/yr..... Pump test data: Well water was..... ft. after..... hours pumping..... gpm Est. Yield..... gpm: Well water was..... ft. after..... hours pumping..... gpm WELL WATER TO BE USED AS: 5 Public water supply 8 Air conditioning 11 Injection well 1 Domestic 3 Feedlot 6 Oil field water supply 9 Dewatering 12 Other (Specify below) 2 Irrigation 4 Industrial 7 Domestic (lawn & garden) <u>10 Monitoring well</u> Was a chemical/bacteriological sample submitted to Department? Yes No <u>X</u> If yes, mo/day/yr Sample was submitted..... <u>N/A</u> Water well disinfected? Yes No <u>X</u>	
-- NW --	-- NE --	
-- SW --	-- SE --	
5 TYPE OF CASING USED: 5 Wrought Iron 8 Concrete tile CASING JOINTS: Glued..... Clamped..... 1 Steel 3 RMP (SR) 6 Asbestos-Cement 9 Other (specify below) Welded..... <u>7 PVC</u> 4 ABS 7 Fiberglass <u>Threaded</u> Blank casing diameter in. to ft., Diameter in. to ft., Diameter in. to ft. Casing height above land surface in., Weight <u>54.40</u> lbs./ft. Wall thickness or gauge No. TYPE OF SCREEN OR PERFORATION MATERIAL: 1 Steel 3 Stainless Steel 5 Fiberglass <u>7 PVC</u> 9 ABS 11 Other (Specify) 2 Brass 4 Galvanized Steel 6 Concrete tile 8 RM (SR) 10 Asbestos-Cement 12 None used (open hole) SCREEN OR PERFORATION OPENINGS ARE: 1 Continuous slot <u>3 Mill slot</u> 5 Gauzed wrapped 7 Torch cut 9 Drilled holes 11 None (open hole) 2 Louvered shutter 4 Key punched 6 Wire wrapped 8 Saw cut 10 Other (specify) SCREEN-PERFORATED INTERVALS: From <u>37.5</u> ft. to <u>17.5</u> ft., From ft. to ft. GRAVEL PACK INTERVALS: From <u>5</u> ft. to <u>17.5</u> ft., From ft. to ft. From ft. to ft., From ft. to ft.	
6 GROUT MATERIAL: 1 Neat cement 2 Cement grout <u>3 Bentonite</u> 4 Other Grout Intervals: From <u>2</u> ft. to <u>17.5</u> ft., From ft. to ft., From ft. to ft. What is the nearest source of possible contamination: 1 Septic tank 4 Lateral lines 7 Pit privy 10 Livestock pens 13 Insecticide storage 16 Other (specify 2 Sewer lines 5 Cess pool 8 Sewage lagoon <u>11 Fuel storage</u> 14 Abandoned water well below) 3 Watertight sewer lines 6 Seepage pit 9 Feedyard 12 Fertilizer storage 15 Oil well/gas well Direction from well? How many feet?	
<table border="1"><thead><tr><th>FROM</th><th>TO</th><th>LITHOLOGIC LOG</th><th>FROM</th><th>TO</th><th>PLUGGING INTERVALS</th></tr></thead><tbody><tr><td></td><td></td><td></td><td><u>0</u></td><td><u>6"</u></td><td><u>Concrete</u></td></tr><tr><td></td><td></td><td></td><td><u>6"</u></td><td><u>2'</u></td><td><u>Top soil</u></td></tr><tr><td></td><td></td><td></td><td><u>2</u></td><td><u>17.5</u></td><td><u>Bentonite</u></td></tr><tr><td></td><td></td><td></td><td></td><td></td><td></td></tr><tr><td></td><td></td><td></td><td></td><td></td><td></td></tr><tr><td></td><td></td><td></td><td></td><td></td><td></td></tr><tr><td></td><td></td><td></td><td></td><td></td><td></td></tr><tr><td></td><td></td><td></td><td></td><td></td><td></td></tr><tr><td></td><td></td><td></td><td></td><td></td><td></td></tr><tr><td></td><td></td><td></td><td></td><td></td><td></td></tr></tbody></table>		FROM	TO	LITHOLOGIC LOG	FROM	TO	PLUGGING INTERVALS				<u>0</u>	<u>6"</u>	<u>Concrete</u>				<u>6"</u>	<u>2'</u>	<u>Top soil</u>				<u>2</u>	<u>17.5</u>	<u>Bentonite</u>	
FROM	TO	LITHOLOGIC LOG	FROM	TO	PLUGGING INTERVALS	
			<u>0</u>	<u>6"</u>	<u>Concrete</u>	
			<u>6"</u>	<u>2'</u>	<u>Top soil</u>	
			<u>2</u>	<u>17.5</u>	<u>Bentonite</u>	
7 CONTRACTOR'S OR LANDOWNER'S CERTIFICATION: This water well was (1) constructed, (2) reconstructed, or <u>(3) plugged</u> under my jurisdiction and was completed on (mo/day/year) <u>8-14-08</u> , and this record is true to the best of my knowledge and belief. Kansas Water Well Contractor's License No. <u>759</u> This Water Well Record was completed on (mo/day/year) <u>8-23-08</u> under the business name of <u>RAZEK Environmental, LLC</u> by (signature) <u>[Signature]</u> INSTRUCTIONS: Use typewriter or ball point pen. PLEASE PRESS FIRMLY and PRINT clearly. Please fill in blanks, underline or circle the correct answers. Send top three copies to Kansas Department of Health and Environment, Bureau of Water, Geology Section, 1000 SW Jackson St., Suite 420, Topeka, Kansas 66612-1367. Telephone 785-296-5522. Send one to WATER WELL OWNER and retain one for your records. Fee of \$5.00 for each constructed well. Visit us at http://www.kdheks.gov/waterwell/index.html .	

LEGEND:


MW-01 MONITORING WELL
 <1.0 Well Identification
 Benzene Concentration in
 micrograms per liter (ug/l)

A & D MOBILE HOMES

CAREY LANE

PUBLIC STORAGE

SENECA STREET

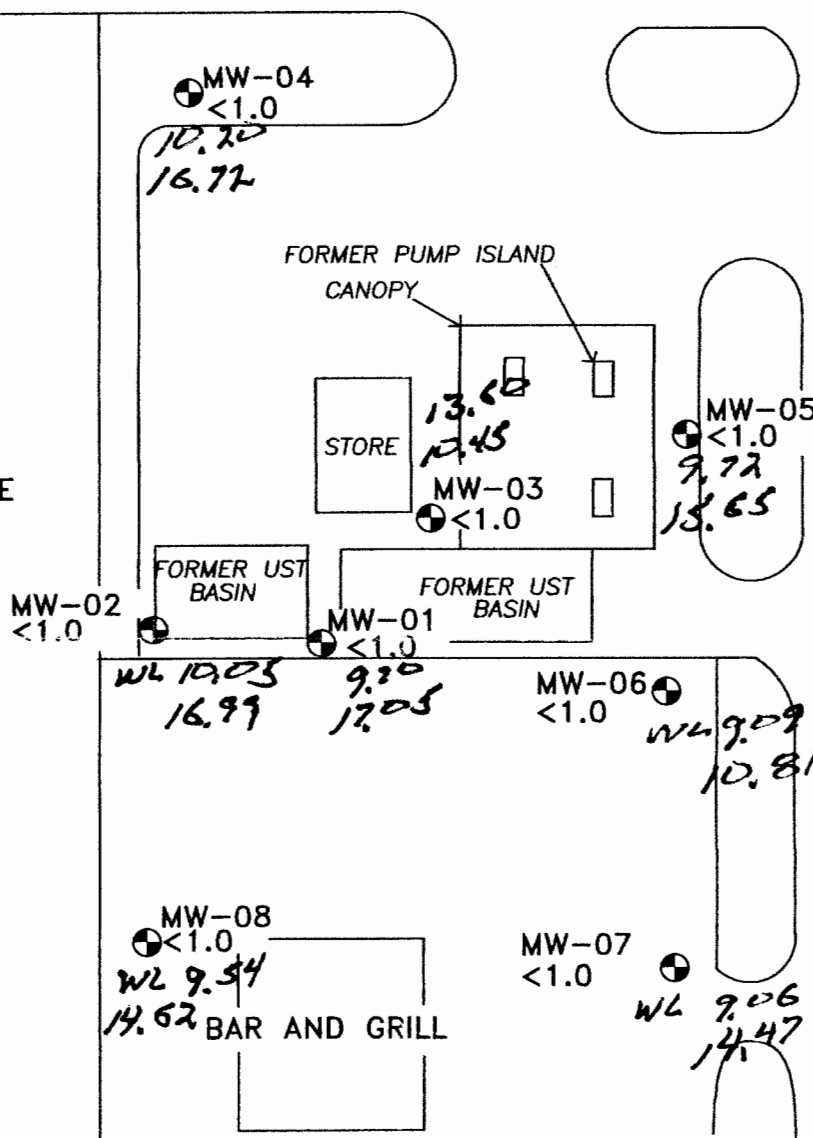

0 30 60 120
 APPROXIMATE SCALE (FEET)

**BENZENE ISOCONTOUR MAP
 (JANUARY 2, 2008)**

TPI STATION NO. 2175
 3801 SOUTH SENECA
 WICHITA, KANSAS

FIGURE
 2

PROJECT NUMBER:
 17.75250.2175

CHECKED BY:

JLA 01/16/08

DRAWING FILE: FIG4.DWG

DRAWN BY:
 JLA 04/06/07

VATC ASSOCIATES INC.