

# WATER WELL RECORD MW-2

**Form WWC-5**

Division of Water Resources; App. No.

EAST

KSA 82a-1212

**LEGEND:**


MW-01 MONITORING WELL  
 <1.0 Well Identification  
 Benzene Concentration in  
 micrograms per liter (ug/l)

A & D MOBILE HOMES

CAREY LANE

PUBLIC STORAGE

SENECA STREET

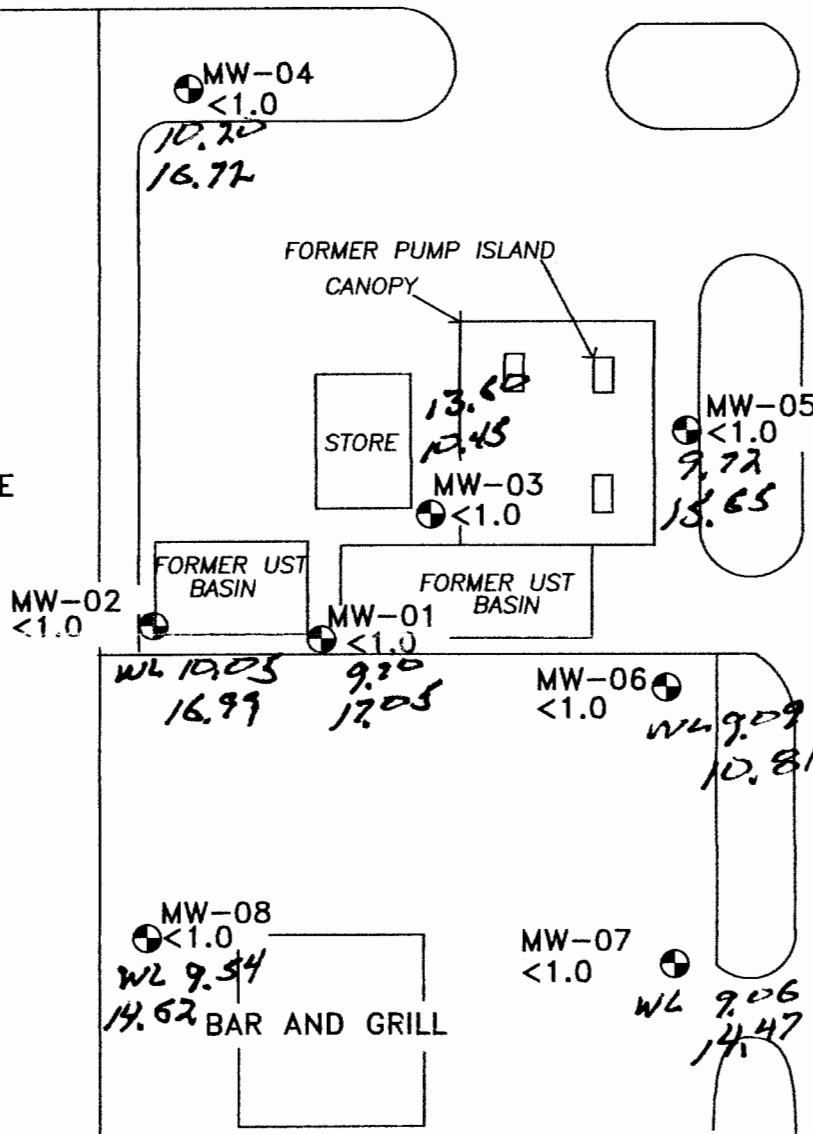

0 30 60 120  
 APPROXIMATE SCALE (FEET)

**BENZENE ISOCONTOUR MAP  
 (JANUARY 2, 2008)**

TPI STATION NO. 2175  
 3801 SOUTH SENECA  
 WICHITA, KANSAS

FIGURE  
 2

PROJECT NUMBER:  
 17.75250.2175

CHECKED BY:  
 JLA 01/16/08

DRAWING FILE: FIG4.DWG

DRAWN BY:  
 JLA 04/06/07

**VATC ASSOCIATES INC.**