

Form WWC-5

EAST

KSA 82a-1212

LEGEND:


MW-01 MONITORING WELL
 <1.0 Well Identification
 Benzene Concentration in
 micrograms per liter (ug/l)

A & D MOBILE HOMES

CAREY LANE

PUBLIC STORAGE

SENECA STREET

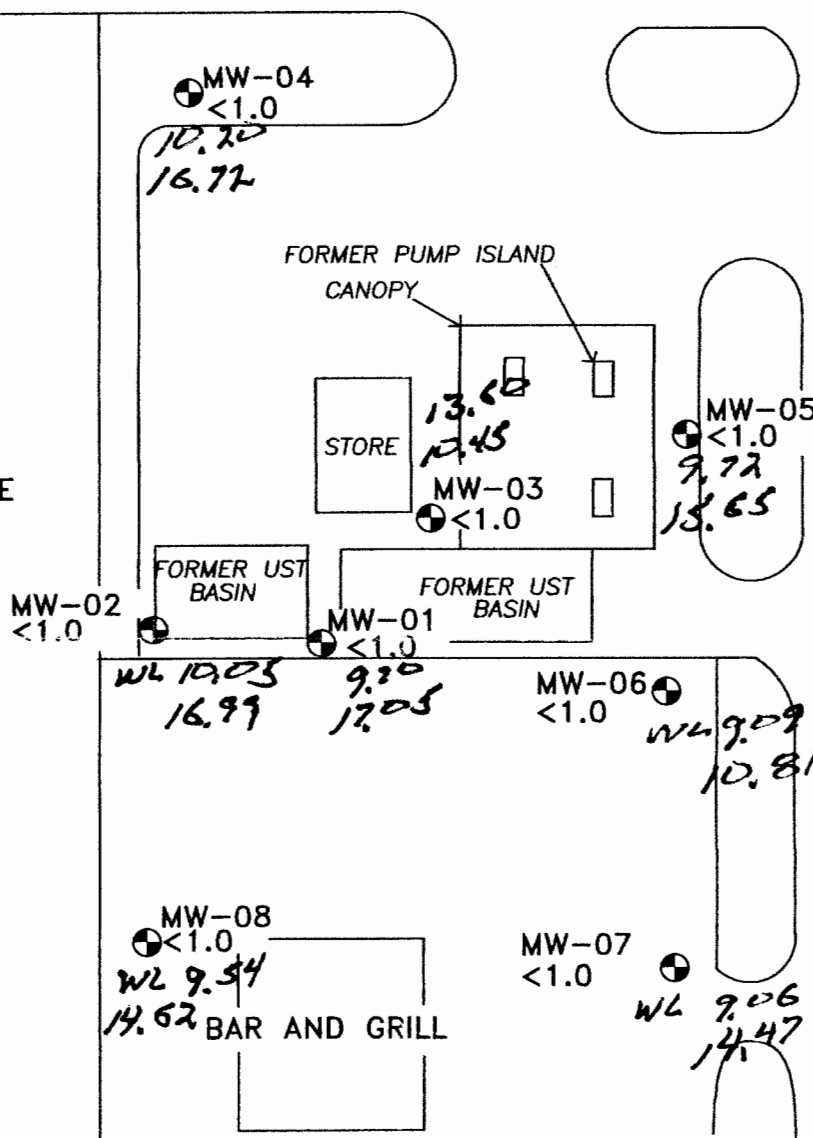

0 30 60 120
 APPROXIMATE SCALE (FEET)

**BENZENE ISOCONTOUR MAP
 (JANUARY 2, 2008)**

TPI STATION NO. 2175
 3801 SOUTH SENECA
 WICHITA, KANSAS

FIGURE
 2

PROJECT NUMBER:
 17.75250.2175

CHECKED BY:

JLA 01/16/08

DRAWING FILE: FIG4.DWG

DRAWN BY:
 JLA 04/06/07

VATC ASSOCIATES INC.